


1	LOCATION OF WATER WELL:	Fraction	Section Number	Township Number	Range Number
	County: Shawnee	NE 1/4 NE 1/4 NE 1/4	1	12	14 E

Distance and direction from nearest town or city street address of well if located within city?
XXXXXXXXXXXX Intersection of Knottingham & 33rd St. Topeka, Ks.

2	WATER WELL OWNER: USD 437 Washburn Rural Elm School C/o Jim Latimer	Board of Agriculture, Division of Water Resources
	RR #, St. Address, Box #: 3639 SW Summerfield Dr.	Application Number:
	City, State, ZIP Code : Topeka, Ks. 66614-3974	

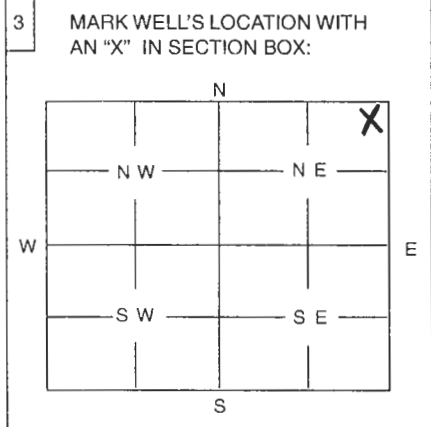

4 DEPTH OF WELL **1 @ 300** ft

WELL'S STATIC WATER LEVEL _____ ft.

WELL WAS USED AS:

1 Domestic	5 Public Water Supply	9 Dewatering
2 Irrigation	6 Oil Field Water Supply	10 Monitoring Well
3 Feedlot	7 Domestic (Lawn & Garden)	11 Injection Well
4 Industrial	8 Air Conditioning	<input checked="" type="checkbox"/> Other Geothermal

Was a chemical / bacteriological sample submitted to Department? Yes _____ No _____
 If yes, mo/day/yr sample was submitted _____

Water Well Disinfected: Yes _____ No _____

5 TYPE OF BLANK CASING USED:

1 Steel	3 RMP (SR)	5 Wrought	7 Fiberglass	<input checked="" type="checkbox"/> Other (Specify below)
2 PVC	4 ABS	6 Asbestos-Cement	8 Concrete Tile	Polyethylene

Blank casing diameter **1** in. Was casing pulled? Yes _____ No _____ If yes, how much _____
 Casing height above or below land surface _____ in.

6 GROUT PLUG MATERIAL: 1 Neat cement 2 Cement grout Bentonite 4 Other _____

Grout Plug Intervals: From **0** ft. to **300** ft., From _____ ft. to _____ ft., From _____ to _____ ft.

What is the nearest source of possible contamination: **None within 1/4 mile**

1 Septic tank	6 Seepage pit	11 Fuel storage	16 Other (specify below)
2 Sewer lines	7 Pit privy	12 Fertilizer storage	
3 Watertight sewer lines	8 Sewage lagoon	13 Insecticide storage	
4 Lateral lines	9 Feedyard	14 Abandoned water well	
5 Cess Pool	10 Livestock pens	15 Oil well/Gas well	

Direction from well? _____ How many feet? _____

FROM	TO	LOG XXXXXXXXXXXX	
0	7	Topsoil	
7	28	Clay, brown	
28	30	Shale, gray	
30	34	Limestone	
34	56	Shale, gray	
56	61	Limestone	
61	128	Shale, gray	
			128-150 Limestone
			150-157 Shale, gray/black Shale, gray
			157-167 Limestone
			167-170 Shale, gray
			170-175 Limestone
			175-207 Shale, gray
			207-211 Limestone
			211-235 Shale, lt. gray
			235-240 Shale, black
			240-244 Limestone
			244-252 Shale, lt. gray
			252-260 Limestone

7 CONTRACTOR'S OR LANDOWNER'S CERTIFICATION: This water well was plugged under my jurisdiction and was completed on (mo/day/year) **4/21/08** and this record is true to the best of my knowledge and belief. Kansas Water Well Contractor's License No. **138** This Water Well Record was completed on (mo/day/year) **5/12/08** under the business name of **Peterson Irrigation, Inc.**

by (signature) *Mike Peterson*

INSTRUCTIONS: Use typewriter or ball point pen. Please press firmly and print clearly. Please fill in blanks, underline or circle the correct answers. Send top three copies to Kansas Department of Health and Environment, Bureau of Water, Topeka, Kansas 66620-0001. Telephone: 785/296-3565. Send one to Water Well Owner and retain one for your records.