


1	LOCATION OF WATER WELL:	Fraction	Section Number	Township Number	Range Number
	County: <u>Shawnee</u>	<u>SW 1/4 SW 1/4 NW 1/4</u>	<u>15</u>	<u>125</u>	<u>14</u> <small>EW</small>

Distance and direction from nearest town or city, street address of well if located within city?
Well is located at 3050 SW Hays Rd

2	WATER WELL OWNER: <u>Lamy Mather</u>	Board of Agriculture, Division of Water Resources
	RR #, St. Address, Box #: <u>7537 SW Robinhood Ct.</u>	Application Number: _____
	City, State, ZIP Code: <u>Topeka, KS 66614</u>	

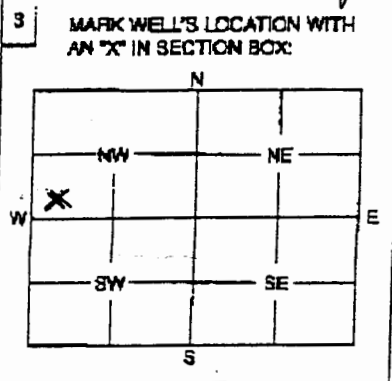

4	DEPTH OF WELL <u>20</u> ft.	
	WELL'S STATIC WATER LEVEL <u>5</u> ft.	
WELL WAS USED AS:		
1 Domestic	5 Public Water Supply	9 Dewatering
2 Irrigation	6 Oil Field Water Supply	10 Monitoring Well
3 Feedlot	7 Domestic (Lawn & Garden)	11 Injection Well
4 Industrial	8 Air Conditioning	12 Other <u>Abandoned</u>
Was a chemical / bacteriological sample submitted to Department? Yes _____ No <input checked="" type="checkbox"/>		
If yes, mo/day/yr sample was submitted _____		
Water Well Disinfected: Yes <input checked="" type="checkbox"/> No _____		

5	TYPE OF BLANK CASING USED:	
	1 Steel	3 RMP (SR)
	2 PVC	4 ABS
	5 Wrought	6 Asbestos-Cement
	7 Fiberglass	8 Concrete Tile
	9 Other (Specify below) <u>Rock lined</u>	
	Blank casing diameter <u>60</u> in.	Was casing pulled? Yes _____ No <input checked="" type="checkbox"/>
	Casing height above or below land surface <u>18</u> in.	If yes, how much _____

6	GROUT PLUG MATERIAL:	1 Neat cement	2 Cement grout	3 Bentonite	4 Other _____
	GROUT PLUG INTERVALS:	From <u>5</u> ft. to <u>4'6"</u> ft.	From _____ ft. to _____ ft.	From _____ ft. to _____ ft.	

What is the nearest source of possible contamination:

1 <u>Septic tank</u>	8 Seepage pit	11 Fuel storage	16 Other (specify below) _____
2 Sewer lines	7 Pit privy	12 Fertilizer storage	
3 Watertight sewer lines	8 Sewage lagoon	13 Insecticide storage	
4 Lateral lines	9 Feedyard	14 Abandoned water well	
5 Cess pool	10 Livestock pens	15 Oil well/Gas well	

Direction from well? Southwest How many feet? 200 ft

FROM	TO	PLUGGING MATERIALS
<u>20'</u>	<u>5'</u>	<u>Sand</u>
<u>5'</u>	<u>4'6"</u>	<u>Bentonite</u>
<u>4'6"</u>	<u>0</u>	<u>Topsoil</u>

7	CONTRACTOR'S OF LANDOWNER'S CERTIFICATION: This water well was plugged under my jurisdiction and was completed on (mo/day/year) <u>12-4-09</u> and this record is true to the best of my knowledge and belief. Kansas Water Well Contractor's License No. _____ This Water Well Record was completed on (mo/day/year) _____ under the business name of _____ by (signature) <u>[Signature]</u>
---	--

INSTRUCTIONS: Use typewriter or ball point pen. Please press firmly and print clearly. Please fill in blanks, underline or circle the correct answers. Send top three copies to Kansas Department of Health and Environment, Bureau of Water, Geology Section, 1000 SW Jackson St., Ste. 420, Topeka, Kansas 66612-1367. Telephone: 785/296-5522. Send one to Water Well Owner and retain one for your records.

White