

WATER WELL RECORD

Form WWC-5


Division of Water Resources App. No.

MP3

1 LOCATION OF WATER WELL: County: Shawnee Fraction SE 1/4 SE 1/4 SE 1/4 SE 1/4 Section Number 3 Township No. T 12 S Range Number R 14 [X]E []W

Street/Rural Address of Well Location; if unknown, distance & direction from nearest town or intersection: Located approx. 60'N & 65'W of the intersection of 21st & Hodges. Global Positioning System (GPS) information: Latitude: 39.0291 Longitude: 95.8354 Elevation: 1050 Datum: [X] WGS 84, [] NAD 83, [] NAD 27 Collection Method: [] GPS unit, [X] Digital Map/Photo, [X] Topographic Map, [] Land Survey Est. Accuracy: [] <3 m, [] 3-5 m, [X] 5-15 m, [] >15 m

2 WATER WELL OWNER: Shawnee County Refuse Department RR#, Street Address, Box #: 1515 NW Saline, Suite 150 City, State, ZIP Code: Topeka, KS 66618-2844

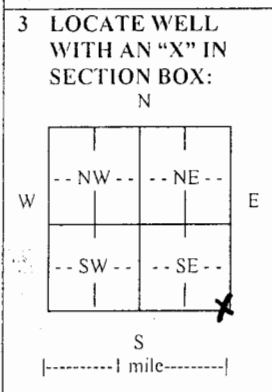

3 LOCATE WELL WITH AN "X" IN SECTION BOX: 4 DEPTH OF COMPLETED WELL 25 ft. Depth(s) Groundwater Encountered (1) 15.5 ft. (2) ft. (3) ft. WELL'S STATIC WATER LEVEL 15.5 ft. below land surface measured on mo/day/yr. 10/28/09 Pump test data: Well water was ft. after hours pumping gpm EST. YIELD gpm Well water was ft. after hours pumping gpm Bore Hole Diameter 9 in. to 25 ft., and in. to ft. WELL WATER TO BE USED AS: [] Public water supply [] Geothermal [] Injection well [] Domestic [] Feedlot [] Oil field water supply [] Dewatering [X] Other (Specify below) [] Irrigation [] Industrial [] Domestic-lawn & garden [X] Monitoring well [] Landfill Gas Was a chemical/bacteriological sample submitted to Department? [] Yes [X] No If yes, mo/day/yr sample was submitted Water well disinfected? [] Yes [X] No

5 TYPE OF CASING USED: [] Steel [X] PVC [] Other CASING JOINTS: [] Glued [] Clamped [] Welded [X] Threaded Casing diameter 2 in. to 25 ft., Diameter in. to ft. Casing height above land surface 36 in., Weight lbs./ft., Wall thickness or gauge No. TYPE OF SCREEN OR PERFORATION MATERIAL: [] Steel [] Stainless Steel [X] PVC [] Other (Specify) [] Brass [] Galvanized Steel [] None used (open hole) SCREEN OR PERFORATION OPENINGS ARE: [] Continuous slot [X] Mill slot [] Gauze wrapped [] Torch cut [] Drilled holes [] None (open hole) [] Louvered shutter [] Key punched [] Wire wrapped [] Saw cut [] Other (specify) SCREEN-PERFORATED INTERVALS: From 5 ft. to 25 ft., From ft. to ft. GRAVEL PACK INTERVALS: From 3 ft. to 25 ft., From ft. to ft.

6 GROUT MATERIAL: [] Neat cement [X] Cement grout [X] Bentonite [] Other Grout Intervals: From 0 ft. to 1 ft., From 1 ft. to 3 ft., From ft. to ft. What is the nearest source of possible contamination: [] Septic tank [] Lateral lines [] Pit privy [] Livestock pens [] Insecticide storage [X] Other (specify below) [] Sewer lines [] Cesspool [] Sewage lagoon [] Fuel storage [] Abandoned water well [] Watertight sewer lines [] Seepage pit [] Feedyard [] Fertilizer storage [] Oil well/gas well [] Landfill Direction from well West Distance from well 400 feet

Table with columns: FROM, TO, LITHOLOGIC LOG, FROM, TO, LITHO. LOG (cont.) or PLUGGING INTERVALS. Rows: 0-3 Clay, brown; 3-12.5 Shale, yellow brown; 12.5-15 Limestone, orange brown; 14-18 Shale, yellow; 18-25 Shale, gray.

7 CONTRACTOR'S OR LANDOWNER'S CERTIFICATION: This water well was [X] constructed, [] reconstructed, or [] plugged under my jurisdiction and was completed on (mo/day/year) 10-28-09 and this record is true to the best of my knowledge and belief. Kansas Water Well Contractor's License No. 416 This Water Well Record was completed on (mo/day/year) under the business name of Terracon by (signature)

INSTRUCTIONS: Use typewriter or ball point pen. PLEASE PRESS FIRMLY and PRINT clearly. Please fill in blanks and check the correct answers. Send three copies (white, blue, pink) to Kansas Department of Health and Environment, Bureau of Water, Geology Section, 1000 SW Jackson St., Suite 420, Topeka, Kansas 66612-1367. Telephone 785-296-5522. Send one copy to WATER WELL OWNER and retain one for your records. Include fee of \$5.00 for each constructed well. Visit us at http://www.kdheks.gov/waterwell/index.html.