

234

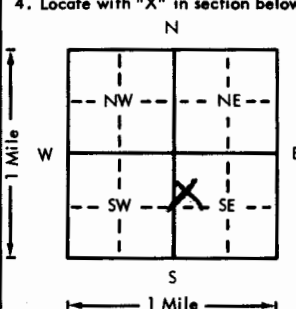
Yjd

USE TYPEWRITER OR BALL POINT PEN-PRESS FIRMLY, PRINT CLEARLY.

WATER WELL RECORD
KSA 82a-1201-1215

DBC

Kansas Department of Health and Environment-Division of Environment
(Water well Contractors)
Topeka, Kansas 66620

1. Location of well:		County Shawnee	Fraction SW 1/4 NW 1/4 SE 1/4	Section number I3	Township number T I2 South S	Range number R I4 East E/W
X Distance and direction from nearest town or city: Street address of well location if in city:				3. Owner of well: William B Allens R.R. or street: 7941 Southwest 33 Street City, state, zip code: Topeka Kansas		
4. Locate with "X" in section below: Sketch map: 				6. Bore hole dia. 10" in. Completion date 8/5/76 Well depth 44 ft.		
5. Type and color of material				7. <input type="checkbox"/> Cable tool <input checked="" type="checkbox"/> Rotary <input type="checkbox"/> Driven <input type="checkbox"/> Dug <input type="checkbox"/> Hollow rod <input type="checkbox"/> Jetted <input type="checkbox"/> Bored <input type="checkbox"/> Reverse rotary		
				8. Use: <input type="checkbox"/> Domestic <input checked="" type="checkbox"/> Public supply <input type="checkbox"/> Industry <input type="checkbox"/> Irrigation <input type="checkbox"/> Air conditioning <input type="checkbox"/> Stock <input type="checkbox"/> Lawn <input type="checkbox"/> Oil field water <input type="checkbox"/> Other		
				9. Casing: Material PVC Height: <input checked="" type="checkbox"/> Above <input type="checkbox"/> below Threaded <input type="checkbox"/> Welded <input type="checkbox"/> Surface 36" in. RMP <input type="checkbox"/> PVC <input checked="" type="checkbox"/> Weight 200 lbs./ft. Dia. 5 in. to 24 ft. depth Wall Thickness: inches or Dia. <input type="checkbox"/> in. to <input type="checkbox"/> ft. depth gage No. 1258		
				10. Screen: Manufacturer's name Modern Pipe Type PVC Dia. 5" Slot/gauze # Length 20ft Set between 24 ft. and 44 ft. ft. and <input type="checkbox"/> ft. Gravel pack? Yes Size range of material 3/8"		
				11. Static water level: <input type="checkbox"/> mo./day/yr. 7ft. ft. below land surface Date 8/20/76		
				12. Pumping level below land surfaces: <input type="checkbox"/> ft. after <input type="checkbox"/> hrs. pumping <input type="checkbox"/> g.p.m. <input type="checkbox"/> ft. after <input type="checkbox"/> hrs. pumping <input type="checkbox"/> g.p.m. Estimated maximum yield 7 g.p.m.		
				13. Water sample submitted: <input type="checkbox"/> mo./day/yr. <input type="checkbox"/> Yes <input checked="" type="checkbox"/> No Date <input type="checkbox"/>		
				14. Well head completion: <input checked="" type="checkbox"/> Pitless adapter <input type="checkbox"/> inches above grade		
				15. Well grouted? Yea With: <input checked="" type="checkbox"/> Neat cement <input type="checkbox"/> Bentonite <input type="checkbox"/> Concrete Depth: From 3 ft. to I3 ft.		
				16. Nearest source of possible contamination: ft. 75 Direction South Type Ditch Well disinfected upon completion? <input checked="" type="checkbox"/> Yes <input type="checkbox"/> No		
				17. Pump: <input type="checkbox"/> Not installed Manufacturer's name Pumpco Model number 102s58 HP 3/4 Volts 230 Length of drop pipe 37 ft. capacity 10 g.p.m. Type: <input checked="" type="checkbox"/> Submersible <input type="checkbox"/> Turbine <input type="checkbox"/> Jet <input type="checkbox"/> Reciprocating <input type="checkbox"/> Centrifugal <input type="checkbox"/> Other		
				20. Water well contractor's certification: This well was drilled under my jurisdiction and this report is true to the best of my knowledge and belief. Cummings Drilling Co 148 Business name License No. Address 1000 Topeka, KS. Signed [Signature] Date 8/20/76 Authorized representative		
18. Elevation: 1022 Topography: rm <input type="checkbox"/> Hill <input type="checkbox"/> Slope <input type="checkbox"/> Upland <input checked="" type="checkbox"/> Valley		19. Remarks: Concrete slab be installed by customer				

12 140 13
T R Sec
1/4 1/4 1/4
SOUTH E