

USE TYPEWRITER OR BALL POINT PEN-PRESS FIRMLY, PRINT CLEARLY.

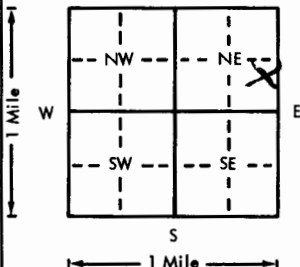
WATER WELL RECORD
KSA 82a-1201-1215

Kansas Department of Health and Environment-Division of Environment
(Water well Contractors)
Topeka, Kansas 66620

235 SIC LAB AVE. ✓

yjd

ADA

1. Location of well:	County Shawnee	Fraction NE 1/4 SE 1/4 NE 1/4	Section number 13	Township number T 12 S	Range number R 14 E W
2. Distance and direction from nearest town or city: Street address of well location if in city:			3. Owner of well: Jepson Dick R.R. or street: 3126 Indian Hills Rd City, state, zip code: Topeka Kansas		
4. Locate with "X" in section below: Sketch map: 			6. Bore hole dia. 10 1/2 in. Completion date 8/14/76 Well depth 39 ft.		
			7. <input checked="" type="checkbox"/> Cable tool <input checked="" type="checkbox"/> Rotary <input type="checkbox"/> Driven <input type="checkbox"/> Dug <input type="checkbox"/> Hollow rod <input type="checkbox"/> Jetted <input type="checkbox"/> Bored <input type="checkbox"/> Reverse rotary		
			8. Use: <input checked="" type="checkbox"/> Domestic <input checked="" type="checkbox"/> Public supply <input type="checkbox"/> Industry <input type="checkbox"/> Irrigation <input type="checkbox"/> Air conditioning <input type="checkbox"/> Stock <input type="checkbox"/> Lawn <input type="checkbox"/> Oil field water <input type="checkbox"/> Other		
			9. Casing: Material Steel Height: Above or below Threaded <input type="checkbox"/> Welded <input checked="" type="checkbox"/> Surface 2 1/2 in. RMP <input type="checkbox"/> PVC <input checked="" type="checkbox"/> Weight 188 lbs./ft. Dia. 2 1/2 in. to 21 ft. depth Wall Thickness: inches or Dia. 5 in. to 39 ft. depth Log No. _____		
5. Type and color of material			10. Screen: Manufacturer's name Valley Steel		
			Type Steel Dia. 65/8 Slot/gauze 1/4 Holds Length 7ft Set between 14 ft. and 21 ft. 5 ft. and 39 ft. Gravel pack? Yes Size range of material 3		
			11. Static water level: _____ mo./day/yr. 4 ft. below land surface Date 8/14/76		
			12. Pumping level below land surfaces: _____ ft. after _____ hrs. pumping _____ g.p.m. _____ ft. after _____ hrs. pumping _____ g.p.m. Estimated maximum yield 15 g.p.m.		
			13. Water sample submitted: _____ mo./day/yr. <input type="checkbox"/> Yes <input checked="" type="checkbox"/> No Date _____		
			14. Well head completion: <input checked="" type="checkbox"/> Pitless adapter _____ Inches above grade		
			15. Well grouted? Yes With: <input checked="" type="checkbox"/> Neat cement <input type="checkbox"/> Bentonite <input type="checkbox"/> Concrete Depth: From 2 ft. to 12 ft.		
			16. Nearest source of possible contamination: ft. 30 Direction South Type Ditch Well disinfected upon completion? <input checked="" type="checkbox"/> Yes <input type="checkbox"/> No		
			17. Pump: Not installed Manufacturer's name Pumpco Model number 102536 HP 1/3 Volts 230 Length of drop pipe 30 ft. capacity 7 g.p.m. Type: <input checked="" type="checkbox"/> Submersible <input type="checkbox"/> Turbine <input type="checkbox"/> Jet <input type="checkbox"/> Reciprocating <input type="checkbox"/> Centrifugal <input type="checkbox"/> Other		
18. Elevation: 1038 Topography? <input type="checkbox"/> Hill <input type="checkbox"/> Slope <input type="checkbox"/> Upland <input checked="" type="checkbox"/> Valley			19. Remarks: Concrete slab to be installed by customer		
			20. Water well contractor's certification: This well was drilled under my jurisdiction and this report is true to the best of my knowledge and belief. Cummings Drilling Co 148 Business name _____ License No. _____ Address P.O. Box Topeka KS Signed Heater Cummings Date 9/28/76 Authorized representative		

T 12 S R 14 E W Sec 13 NE SE 1/4