


1 LOCATION OF WATER WELL: County: **SHAWNEE** Fraction: **NW 1/4 NE 1/4 SW 1/4** Section Number: **22** Township Number: **T 12 S** Range Number: **R 14 EW**

Distance and direction from nearest town or city street address of well if located within city?
1.8 W .5 N OF INTERSECTION OF 45TH & AD BURN - SW TOPEKA KS

2 WATER WELL OWNER: **SHAWNEE COUNTY RECREATIONAL MANAGEMENT CORP.**
 RR#, St. Address, Box #: **9940 SW 45TH** Board of Agriculture, Division of Water Resources
 City, State, ZIP Code: **TOPEKA KS 66810** Application Number:

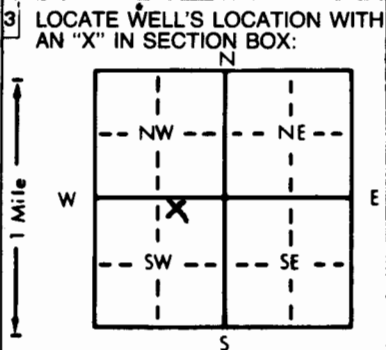

4 DEPTH OF COMPLETED WELL: **87** ft. ELEVATION: _____
 Depth(s) Groundwater Encountered 1. **67** ft. 2. _____ ft. 3. _____ ft.
 WELL'S STATIC WATER LEVEL: **48** ft. below land surface measured on mo/day/yr **12-19-88**
 Pump test data: Well water was _____ ft. after _____ hours pumping _____ gpm
 Est. Yield **3.6 GPH** Well water was _____ ft. after _____ hours pumping _____ gpm
 Bore Hole Diameter: **8.98** in. to **87** ft., and _____ in. to _____ ft.
 WELL WATER TO BE USED AS: **NA** 5 Public water supply 8 Air conditioning 11 Injection well
 1 Domestic 3 Feedlot 6 Oil field water supply 9 Dewatering 12 Other (Specify below)
 2 Irrigation 4 Industrial 7 Lawn and garden only 10 Monitoring well _____
 Was a chemical/bacteriological sample submitted to Department? Yes _____ No **X**; If yes, mo/day/yr sample was submitted _____
 Water Well Disinfected? Yes **X** No

5 TYPE OF BLANK CASING USED: **NA** 5 Wrought iron 8 Concrete tile CASING JOINTS: Glued _____ Clamped _____
 1 Steel 3 RMP (SR) 6 Asbestos-Cement 9 Other (specify below) Welded _____
 2 PVC 4 ABS 7 Fiberglass _____ Threaded _____
 Blank casing diameter _____ in. to _____ ft., Dia _____ in. to _____ ft., Dia _____ in. to _____ ft.
 Casing height above land surface: **NA** in., weight _____ lbs./ft. Wall thickness or gauge No. _____
 TYPE OF SCREEN OR PERFORATION MATERIAL: **NA** 7 PVC 10 Asbestos-cement
 1 Steel 3 Stainless steel 5 Fiberglass 8 RMP (SR) 11 Other (specify) _____
 2 Brass 4 Galvanized steel 6 Concrete tile 9 ABS 12 None used (open hole)
 SCREEN OR PERFORATION OPENINGS ARE: **NA** 5 Gauzed wrapped 8 Saw cut 11 None (open hole)
 1 Continuous slot 3 Mill slot 6 Wire wrapped 9 Drilled holes
 2 Louvered shutter 4 Key punched 7 Torch cut 10 Other (specify) _____
 SCREEN-PERFORATED INTERVALS: From _____ ft. to _____ ft., From _____ ft. to _____ ft.
 From _____ ft. to _____ ft., From _____ ft. to _____ ft.
 GRAVEL PACK INTERVALS: From _____ ft. to _____ ft., From _____ ft. to _____ ft.
 From _____ ft. to _____ ft., From _____ ft. to _____ ft.

6 GROUT MATERIAL: **NA** 1 Neat cement 2 Cement grout 3 Bentonite 4 Other _____
 Grout Intervals: From _____ ft. to _____ ft., From _____ ft. to _____ ft., From _____ ft. to _____ ft.
 What is the nearest source of possible contamination:
 1 Septic tank 4 Lateral lines 7 Pit privy 10 Livestock pens 14 Abandoned water well
 2 Sewer lines 5 Cess pool 8 Sewage lagoon 11 Fuel storage 15 Oil well/Gas well
 3 Watertight sewer lines 6 Seepage pit 9 Feedyard 12 Fertilizer storage 16 Other (specify below)
 13 Insecticide storage _____
 Direction from well? _____ How many feet? _____

FROM	TO	LITHOLOGIC LOG	FROM	TO	PLUGGING INTERVALS
0	2	TOP SILT			
2	11	CLAY SILT			
11	19.5	LIME			
19.5	54	SHALE DRK GREY			
54	67	SHALE LT GREY			
67	83	LIME (WATER - 67')			
83	87	SHALE LT GREY			

7 CONTRACTOR'S OR LANDOWNER'S CERTIFICATION: This water well was (1) constructed, (2) reconstructed, or (3) plugged under my jurisdiction and was completed on (mo/day/year) **12-19-88** and this record is true to the best of my knowledge and belief. Kansas Water Well Contractor's License No. **479** This Water Well Record was completed on (mo/day/yr) **12-19-88** under the business name of **EBBERTS DRILLING** by (signature) *Gregory Ebberts*