


Fraction NE 1/4 NW 1/4 NE 1/4	Section Number 12	Township Number T 12 S	Range Number R 15 E
---	-----------------------------	----------------------------------	-------------------------------

County: **Shawnee**
 Distance and direction from nearest town or city street address of well if located within city?
1201 SW 21st. Topeka, KS.

2 WATER WELL OWNER: **Tom Haag**
 RR#, St. Address, Box #: **7233 SE 85th**
 City, State, ZIP Code: **Auburn, KS. 66402**
 Board of Agriculture, Division of Water Resources
 Application Number:

3 LOCATE WELL'S LOCATION WITH AN "X" IN SECTION BOX:

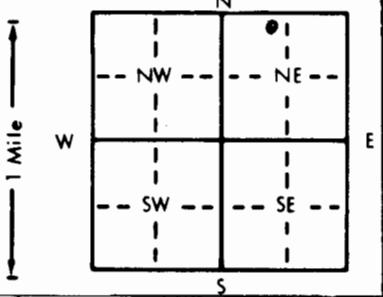

4 DEPTH OF COMPLETED WELL **15'** ft. ELEVATION: _____ ft.
 Depth(s) Groundwater Encountered 1. **8'** ft. 2. _____ ft. 3. _____ ft.
 WELL'S STATIC WATER LEVEL **9.65** ft. below land surface measured on **mo/day/yr 7-13-95**
 Pump test data: Well water was _____ ft. after _____ hours pumping _____ gpm
 Est. Yield _____ gpm: Well water was _____ ft. after _____ hours pumping _____ gpm
 Bore Hole Diameter **8 1/2"** in. to **10'** ft., and **5 1/2"** in. to **15'** ft.
 WELL WATER TO BE USED AS:
 5 Public water supply 8 Air conditioning 11 Injection well
 1 Domestic 3 Feedlot 6 Oil field water supply 9 Dewatering 12 Other (Specify below)
 2 Irrigation 4 Industrial 7 Lawn and garden only **10** Monitoring well
 Was a chemical/bacteriological sample submitted to Department? Yes _____ No **X** If yes, mo/day/yr sample was submitted _____
 Water Well Disinfected? Yes _____ No **10**

5 TYPE OF BLANK CASING USED:
 1 Steel 3 RMP (SR) 5 Wrought iron 8 Concrete tile CASING JOINTS: Glued _____ Clamped _____
2 PVC 4 ABS 6 Asbestos-Cement 9 Other (specify below) Welded _____
 7 Fiberglass Threaded _____ X
 Blank casing diameter **2.375** in. to **5'** ft., Dia _____ in. to _____ ft., Dia _____ in. to SDR 13 _____ ft.
 Casing height above land surface **Flush Mt.** in., weight _____ lbs./ft. Wall thickness or gauge No. **SCH. 40**
 TYPE OF SCREEN OR PERFORATION MATERIAL:
 1 Steel 3 Stainless steel 5 Fiberglass 8 RMP (SR) 10 Asbestos-cement 11 Other (specify) _____
 2 Brass 4 Galvanized steel 6 Concrete tile 9 ABS 12 None used (open hole)
 SCREEN OR PERFORATION OPENINGS ARE:
 1 Continuous slot 3 Mill slot 5 Gauzed wrapped 8 Saw cut 11 None (open hole)
 2 Louvered shutter 4 Key punched 6 Wire wrapped 9 Drilled holes
 7 Torch cut 10 Other (specify) _____
 SCREEN-PERFORATED INTERVALS: From **15'** ft. to **5'** ft., From _____ ft. to _____ ft.
 From _____ ft. to _____ ft., From _____ ft. to _____ ft.
 GRAVEL PACK INTERVALS: From **15'** ft. to **4'** ft., From _____ ft. to _____ ft.
 From _____ ft. to _____ ft., From _____ ft. to _____ ft.

6 GROUT MATERIAL: 1 Neat cement 2 Cement grout 3 Bentonite 4 Other _____
 Grout Intervals: From **4'** ft. to **3'** ft., From **3'** ft. to **0'** ft., From _____ ft. to _____ ft.
 What is the nearest source of possible contamination:
 1 Septic tank 4 Lateral lines 7 Pit privy **11 Fuel storage Fourer** 14 Abandoned water well
 2 Sewer lines 5 Cess pool 8 Sewage lagoon 12 Fertilizer storage 15 Oil well/Gas well
 3 Watertight sewer lines 6 Seepage pit 9 Feedyard 13 Insecticide storage 16 Other (specify below)
 Direction from well? **East** How many feet? **120'**

FROM	TO	LITHOLOGIC LOG	FROM	TO	PLUGGING INTERVALS
0	.75	Asphalt w/ ls.r.x. gravel.			
.75	8	Dk med red brn clay till, oxide staining, fine-coarse sand & gravel, no odor.			
8	10	Olive-dk green gravelly wet clay, strong odor, highly plastic.			
10	13	Limestone-bedrock, fractured.			
13	15	Gray shale, dry, no odor.			

7 CONTRACTOR'S OR LANDOWNER'S CERTIFICATION: This water well was **(1) constructed** (2) reconstructed, or (3) plugged under my jurisdiction and was completed on (mo/day/year) **7-12-95** and this record is true to the best of my knowledge and belief. Kansas Water Well Contractor's License No. _____ 539 This Water Well Record was completed on (mo/day/yr) **7-13-95** under the business name of **JB Environmental Drilling** by (signature) **James Becken**

INSTRUCTIONS: Use typewriter or ball point pen. PLEASE PRESS FIRMLY and PRINT clearly. Please fill in blanks, underline or circle the correct answers. Send top three copies to Kansas Department of Health and Environment, Bureau of Water, Topeka, Kansas 66620-0001. Telephone: 913-296-5545. Send one to WATER WELL OWNER and retain one for your records.

OFFICE USE ONLY T R E W SEC. 1/4 1/4 1/4