


1 LOCATION OF WATER WELL: Fraction NE 1/4 NW 1/4 NE 1/4 Section Number 12 Township Number T 12 S Range Number R 15 E  
 County: SHawnee

Distance and direction from nearest town or city street address of well if located within city?  
1201 SW 21st Street, Topeka, Ks.

2 WATER WELL OWNER: Tom Haag  
 RR#, St. Address, Box #: 7233 SE 85th  
 City, State, ZIP Code: Auburn, KS. 66402  
 Board of Agriculture, Division of Water Resources  
 Application Number:

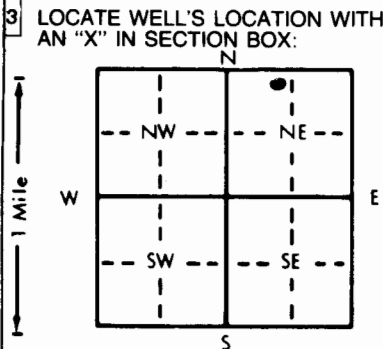

4 DEPTH OF COMPLETED WELL: 10'7" ft. ELEVATION: ..... ft.  
 Depth(s) Groundwater Encountered 1. 6'12" ft. 2. .... ft. 3. .... ft.  
 WELL'S STATIC WATER LEVEL 5.03 ft. below land surface measured on mo/day/yr 7-13-95  
 Pump test data: Well water was ..... ft. after ..... hours pumping ..... gpm  
 Est. Yield ..... gpm: Well water was ..... ft. after ..... hours pumping ..... gpm  
 Bore Hole Diameter: 8 1/2" in. to 6" ft., and 5 1/2" in. to 10'7" ft.  
 WELL WATER TO BE USED AS:  
 1 Domestic 3 Feedlot 6 Oil field water supply 9 Dewatering 12 Other (Specify below)  
 2 Irrigation 4 Industrial 7 Lawn and garden only  10 Monitoring well  
 Was a chemical/bacteriological sample submitted to Department? Yes.....No .....; If yes, mo/day/yr sample was submitted  
 Water Well Disinfected? Yes  No

5 TYPE OF BLANK CASING USED:  
 1 Steel 3 RMP (SR) 5 Wrought iron 8 Concrete tile CASING JOINTS: Glued ..... Clamped .....  
 2 PVC 4 ABS 6 Asbestos-Cement 9 Other (specify below) Welded .....  
 Blank casing diameter 2.375 in. to 3'3" ft., Dia ..... in. to ..... ft., Dia ..... in. to SDR 13 ft.  
 Casing height above land surface Flush Mt in., weight ..... lbs./ft. Wall thickness or gauge No. SCH 40  
 TYPE OF SCREEN OR PERFORATION MATERIAL:  
 1 Steel 3 Stainless steel 5 Fiberglass 8 RMP (SR) 10 Asbestos-cement  
 2 Brass 4 Galvanized steel 6 Concrete tile 9 ABS 11 Other (specify) .....  
 12 None used (open hole)  
 SCREEN OR PERFORATION OPENINGS ARE:  
 1 Continuous slot 3 Mill slot 5 Gauzed wrapped 8 Saw cut 11 None (open hole)  
 2 Louvered shutter 4 Key punched 6 Wire wrapped 9 Drilled holes  
 7 Torch cut 10 Other (specify) .....  
 SCREEN-PERFORATED INTERVALS: From 10'3" ft. to 3'3" ft., From ..... ft. to ..... ft.  
 GRAVEL PACK INTERVALS: From 10'7" ft. to 2'9" ft., From ..... ft. to ..... ft.

6 GROUT MATERIAL: 1 Neat cement 2 Cement grout 3 Bentonite 4 Other .....  
 Grout Intervals: From 2'9" ft. to 1'9" ft., From 1'9" ft. to 0 ft., From ..... ft. to ..... ft.  
 What is the nearest source of possible contamination:  
 1 Septic tank 4 Lateral lines 7 Pit privy 10 Livestock pens 14 Abandoned water well  
 2 Sewer lines 5 Cess pool 8 Sewage lagoon 11 Fuel storage FARMER 15 Oil well/Gas well  
 3 Watertight sewer lines 6 Seepage pit 9 Feedyard 12 Fertilizer storage 16 Other (specify below)  
 13 Insecticide storage  
 Direction from well? West How many feet? 30'

FROM	TO	LITHOLOGIC LOG	FROM	TO	PLUGGING INTERVALS
0	.50	Concrete			
.50	6	Olive green-olive silty clay w/ ls.rx. gravel, soft, moist, mod. to strong odor.			
6	7	Green silty clay, wet, strong odor w/ ls,rx. gravel.			
7	8	Weathered ls.rx. fractured.			
8	10	Gray shale.			
10	10'7	Limestone rx. layer.			

7 CONTRACTOR'S OR LANDOWNER'S CERTIFICATION: This water well was (1)  constructed (2) reconstructed, or (3) plugged under my jurisdiction and was completed on (mo/day/year) 7-5-95 and this record is true to the best of my knowledge and belief. Kansas Water Well Contractor's License No. 539 This Water Well Record was completed on (mo/day/yr) 7-13-95 under the business name of JB Environmental Drilling by (signature) James Bulker

INSTRUCTIONS: Use typewriter or ball point pen. PLEASE PRESS FIRMLY and PRINT clearly. Please fill in blanks, underline or circle the correct answers. Send top three copies to Kansas Department of Health and Environment, Bureau of Water, Topeka, Kansas 66620-0001. Telephone: 913-296-5545. Send one to WATER WELL OWNER and retain one for your records.

OFFICE USE ONLY  
T  
R  
EAW  
SEC.  
1/4  
1/4  
1/4