MW-5

WATER WELL RECORD Form WWC-5 KSA 82a-1212

1 LOCATION OF WATER WELL:	Fraction	Section Number	Township Number	Range Number
County: Shawnee	SW ¼ SW ¼ SW ¼	28	T 12 S	R 15 (E) W

Distance and direction from nearest town or city street address of well if located within city?

5928 SW 53rd, Topeka, Kansas

2 WATER WELL OWNER:

RR#, St. Address, Box # Auburn Washburn C/O Dennis Johnson

City, State, ZIP Code 5926 SW 53rd, Topeka, Ks 66610

Board of Agriculture, Division of Water Resources Application Number: _____

3 LOCATE WELL'S LOCATION WITH AN "X" IN SECTION BOX:

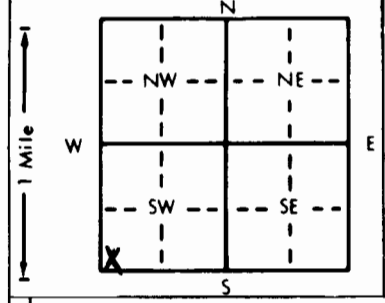

4 DEPTH OF COMPLETED WELL 18.5 ft. ELEVATION: _____

Depth(s) Groundwater Encountered 1. 13.0 ft. 2. _____ ft. 3. _____ ft.

WELL'S STATIC WATER LEVEL 9.5 ft. below land surface measured on mo/day/yr 3-26-97

Pump test data: Well water was _____ ft. after _____ hours pumping _____ gpm

Est. Yield _____ gpm: Well water was _____ ft. after _____ hours pumping _____ gpm

Bore Hole Diameter 8.625 in. to _____ ft., and _____ in. to _____ ft.

WELL WATER TO BE USED AS: 5 Public water supply 8 Air conditioning 11 Injection well

1 Domestic 3 Feedlot 6 Oil field water supply 9 Dewatering 12 Other (Specify below)

2 Irrigation 4 Industrial 7 Lawn and garden only (10) Monitoring well MW-5

Was a chemical/bacteriological sample submitted to Department? Yes — No X; If yes, mo/day/yr sample was submitted _____ Water Well Disinfected? Yes — No X

5 TYPE OF BLANK CASING USED: 5 Wrought iron 8 Concrete tile CASING JOINTS: Glued — Clamped —

1 Steel 3 RMP (SR) 6 Asbestos-Cement 9 Other (specify below) Welded —

(2) PVC 4 ABS 7 Fiberglass _____ Threaded —

Blank casing diameter 2 in. to 8.5 ft., Dia _____ in. to _____ ft., Dia _____ in. to X ft.

Casing height above land surface 24 in., weight _____ lbs./ft. Wall thickness or gauge No. _____

TYPE OF SCREEN OR PERFORATION MATERIAL: SCH 40 (7) PVC 10 Asbestos-cement

1 Steel 3 Stainless steel 5 Fiberglass 8 RMP (SR) 11 Other (specify)

2 Brass 4 Galvanized steel 6 Concrete tile 9 ABS 12 None used (open hole) —

SCREEN OR PERFORATION OPENINGS ARE: 5 Gauzed wrapped 8 Saw cut 11 None (open hole)

1 Continuous slot (3) Mill slot 6 Wire wrapped 9 Drilled holes

2 Louvered shutter 4 Key punched 7 Torch cut 10 Other (specify) —

SCREEN-PERFORATED INTERVALS: From 8.5 ft. to 18.5 ft., From — ft. to — ft.

From — ft. to — ft., From — ft. to — ft.

SAND GRAVEL PACK INTERVALS: From — ft. to — ft., From — ft. to — ft.

From 7.5 ft. to 18.5 ft., From — ft. to — ft.

6 GROUT MATERIAL: 1 Neat cement (2) Cement grout (3) Bentonite 4 Other — —

Grout Intervals: From 2 0 ft. to 5.5 ft., From 3 5.5 ft. to 7.5 ft., From — ft. to — ft.

What is the nearest source of possible contamination:

1 Septic tank 4 Lateral lines 7 Pit privy 10 Livestock pens ~~14~~ Abandoned water well

2 Sewer lines 5 Cess pool 8 Sewage lagoon 11 Fuel storage 15 Oil well/Gas well

3 Watertight sewer lines 6 Seepage pit 9 Feedyard 12 Fertilizer storage (16) Other (specify below)

13 Insecticide storage

Direction from well? How many feet? Contaminated Si

FROM	TO	LITHOLOGIC LOG	FROM	TO	PLUGGING INTERVALS
GL	7.00	Fill, Concrete brecia ans surface silts/clays			
7.00	15.00	Silty Clay (Ch)			
15.00	18.50	Clayey Silt (ML)			
18.50	TD	End of borehole			
					Flush Mount
					waiver
					D.Taylor 12/27/96

7 CONTRACTOR'S OR LANDOWNER'S CERTIFICATION: This water well was (1) constructed (2) reconstructed, or (3) plugged under my jurisdiction and was completed on (mo/day/year) 3-19-97 and this record is true to the best of my knowledge and belief. Kansas Water Well Contractor's License No. 585 This Water Well Record was completed on (mo/day/yr) 3-19-97 under the business name of ACI by (signature) D Johnson for Dennis Johnson

INSTRUCTIONS: Use typewriter or ball point pen. *PLEASE PRESS FIRMLY* and *PRINT* clearly. Please fill in blanks, underline or circle the correct answers. Send top three copies to Kansas Department of Health and Environment, Bureau of Water, Topeka, Kansas 66620-0001. Telephone: 913-296-5545. Send one to WATER WELL OWNER and retain one for your records.

OFFICE USE ONLY T R E/W SEC. ¼ ¼ ¼