


1 LOCATION OF WATER WELL:	Fraction	Section Number	Township Number	Range Number
County: <b>Shawnee</b>	<b>SW ¼ SW ¼ SW ¼</b>	<b>2</b>	<b>12</b>	<b>15-East</b>

Distance and direction from nearest town or city street address of well if located within city?

**2000 Gage Boulevard, Topeka, Kansas**

2 WATER WELL OWNER: **Workingman's Friend Oil, Inc.**  
 RR#, St. Address, Box # **1200 Bank IV Tower** Board of Agriculture, Division of Water Resources  
 City, State, ZIP Code : **Topeka, Kansas 66603** Application Number:

3 MARK WELL'S LOCATION WITH AN "X" IN SECTION BOX:

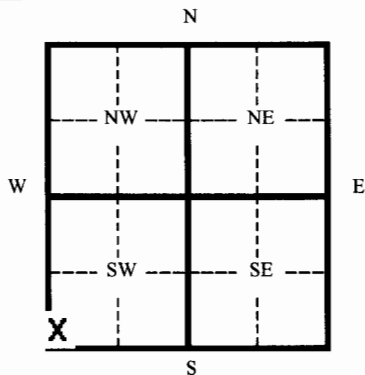

4 DEPTH OF WELL **20.0** ft.

WELL'S STATIC WATER LEVEL **11.97** ft.

WELL WAS USED AS:

- 1 Domestic
- 2 Irrigation
- 3 Feedlot
- 4 Industrial
- 5 Public Water Supply
- 6 Oil Field Water Supply
- 7 Lawn and Garden (domestic)
- 8 Air Conditioning
- 9 Dewatering
- 10 **Monitoring Well**
- 11 Injection Well
- 12 Other

Was a chemical/bacteriological sample submitted to Department? Yes \_\_\_ No **X**

If yes, mo/day/yr sample was submitted \_\_\_\_\_

Water Well Disinfected: Yes \_\_\_ No **X**

5 TYPE OF BLANK CASING USED:

- 1 Steel
- 2 **PVC**
- 3 RMP (SR)
- 4 ABC
- 5 Wrought
- 6 Asbestos-Cement
- 7 Fiberglass
- 8 Concrete Tile
- 9 Other (specify below)

Blank casing diameter **2.375** in. Was casing pulled? Yes **X** No \_\_\_ If yes, how much? \_\_\_\_\_

Casing height above or below land surface **Unknown** in. **Overdrilled well to 20'**

6 GROUT PLUG MATERIAL: 1 Neat cement 2 Cement grout 3 **Bentonite** 4 Other **Soils**

Grout Plug Intervals From **20.0** ft. to **1.0** ft. From **1.0** ft. to **0.0** ft. From \_\_\_ ft. to \_\_\_ ft.

What is the nearest source of possible contamination:

- 1 Septic tank
- 2 Sewer lines
- 3 Watertight sewer lines
- 4 Lateral lines
- 5 Cess Pool
- 6 Seepage pit
- 7 Pit privy
- 8 Sewage lagoon
- 9 Feedyard
- 10 Livestock pens
- 11 **Fuel storage (Former)**
- 12 Fertilizer storage
- 13 Insecticide storage
- 14 Abandoned water well
- 15 Oil well/ Gas well
- 16 Other (specify below)

Direction from well? **N/A** How many feet? **0**

FROM	TO	CODE	PLUGGING MATERIALS
<b>0.0</b>	<b>1.0</b>		<b>Compacted soils</b>
<b>1.0</b>	<b>20.0</b>		<b>Bentonite chips</b>

7 CONTRACTOR'S OR LANDOWNER'S CERTIFICATION: This water well was plugged under my jurisdiction and was completed on (mo/day/yr) **07/13/04** and this record is true to the best of my knowledge and belief. Kansas Water Well Contractor's License No. **692** This Water Well Record was completed on (mo/day/yr) **07/20/04** under the business name of **Quad State Services, Inc.** by (signature) \_\_\_\_\_

INSTRUCTIONS: Please fill in blanks and circle the correct answers. Send three copies to Kansas Department of Health and Environment, Bureau of Water, 1000 S W Jackson St., Ste. 420, Topeka, Kansas 66620-0001. Telephone: 785-296-3565. Send one to Water Well Owner and retain one for your records.