


1 LOCATION OF WATER WELL:	Fraction	Section Number	Township Number	Range Number
County: <b>Shawnee</b>	<b>SW ¼ SW ¼ SW ¼</b>	<b>10</b>	<b>T 12 S</b>	<b>R 15 E</b>

Distance and direction from nearest town or city street address of well if located within city?  
**2820 SW Fairlawn, Topeka (now a drive into 5100 SW 29<sup>th</sup> Street)**

2 WATER WELL OWNER:	TPI Petroleum, Inc	Board of Agriculture, Division of Water Resources
RR#, St. Address, Box # :	<b>5590 Havana Street Bldg B</b>	Application Number:
City, State, ZIP Code :	<b>Denver, CO 80239</b>	

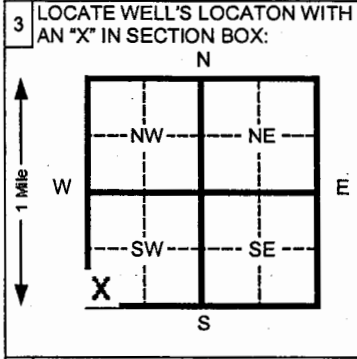

4 DEPTH OF COMPLETED WELL	16 ft.	ELEVATION:	9.38.47 (TOC)
Depth(s) Groundwater Encountered	1 11 ft.	2	ft. 3
WELL'S STATIC WATER LEVEL	8.66 ft. below land surface	measured on	1-20-04
Pump test data:	Well water was	ft. after	hours pumping
Est. Yield	gpm: Well water was	ft. after	hours pumping
Bore Hole Diameter	8.5 in. to	16	ft. and
WELL WATER TO BE USED AS:	5 Public water supply	8 Air conditioning	11 Injection well
	1 Domestic 3 Feed lot 6 Oil field water supply	9 Dewatering	12 Other (Specify below)
	2 Irrigation 4 Industrial 7 Lawn and garden (domestic)	<b>10 Monitoring well</b>	
Was a chemical/bacteriological sample submitted to Department?	Yes	No <b>X</b>	If yes, mo/day/yr sample was submitted
Water Well Disinfected?	Yes	No <b>X</b>	

5 TYPE OF BLANK CASING USED:	5 Wrought Iron	8 Concrete tile	CASING JOINTS: Glued
1 Steel	3 RMP (SR)	6 Asbestos-Cement	9 Other (specify below)
<b>2 PVC</b>	4 ABS	7 Fiberglass	Welded
Blank casing diameter	2 in. to	6 ft., Dia	in. to
Casing height above land surface	Flushmount	in., weight	0.703 lbs./ft. Wall thickness or gauge No.
			Sch. 40

TYPE OF SCREEN OR PERFORATION MATERIAL:	7 PVC	10 Asbestos-cement	11 Other (specify)
1 Steel	3 Stainless steel	5 Fiberglass	8 RMP (SR)
2 Brass	4 Galvanized steel	6 Concrete tile	9 ABS
SCREEN OR PERFORATION OPENINGS ARE:	5 Gauzed wrapped	8 Saw cut	11 None (open hole)
1 Continuous slot	<b>3 Mill slot</b>	6 Wire wrapped	9 Drilled holes
2 Louvered shutter	4 Key punched	7 Torch cut	10 Other (specify)
SCREEN-PERFORATED INTERVALS:	From 6 ft. to	16 ft.	ft. From
GRAVEL PACK INTERVALS:	From 4 ft. to	16 ft.	ft. From

6 GROUT MATERIAL:	1 Neat cement	2 Cement grout	3 Bentonite
Grout Intervals	From 0 ft. to	0.5 ft.	0.5 ft. to
			4 ft. From
What is the nearest source of possible contamination:	10 Livestock pens	14 Abandoned water well	
1 Septic tank	4 Lateral lines	7 Pit privy	11 Fuel storage
2 Sewer lines	5 Cess pool	8 Sewage lagoon	12 Fertilizer storage
3 Watertight sewer lines	6 Seepage pit	9 Feedyard	13 Insecticide storage
			15 Oil well/ Gas well
			16 Other (specify below)
Direction from well?	How many feet?		

FROM	TO	CODE	LITHOLOGIC LOG	FROM	TO	PLUGGING INTERVALS
0	0.42		Concrete			
0.42	16		Clay, with silt, high plasticity, granular, blocky, firm. Soft to medium stiff at five feet.			

7 CONTRACTOR'S OR LANDOWNER'S CERTIFICATION: This water well was	(1) constructed	(2) reconstructed,	or (3) plugged	under my jurisdiction and was
completed on (mo/day/yr)	2-7-05			
Water Well Contractor's License No.	531			
under the business name of	Geotechnical Services, Inc.		by (signature) <i>Alison M. [Signature]</i>	
			This Water Well Record was completed on (mo/day/yr) 2-15-05	

INSTRUCTIONS: Please fill in blanks and circle the correct answers. Send three copies to Kansas Department of Health and Environment, Bureau of Water, 1000 S W Jackson St., Ste. 420, Topeka, Kansas 66612-1367. Telephone: 913-296-5545. Send one to WATER WELL OWNER and retain one for your records.