


WATER WELL RECORD Form WWC-5 KSA 82a-1212

1 LOCATION OF WATER WELL: County: <u>Shawnee</u>	Fraction <u>SW</u> 1/4 <u>SW</u> 1/4 <u>SW</u> 1/4	Section Number <u>2</u>	Township Number T <u>12</u> S	Range Number R <u>15</u> <u>E</u>
---	---	----------------------------	----------------------------------	--------------------------------------

Distance and direction from nearest town or city street address of well if located within city?
2000 Gage Blvd, Topeka, KS.

2 WATER WELL OWNER: Workingman's Friend Oil Inc.
 RR#, St. Address, Box # : 1200 Bank IV Tower
 City, State, ZIP Code : Topeka, Ks. 66603

Board of Agriculture, Division of Water Resources
 Application Number: _____

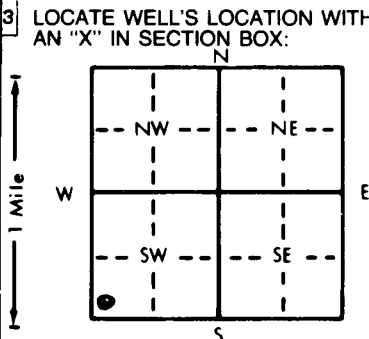

4 DEPTH OF COMPLETED WELL... 20' ft. ELEVATION: _____

Depth(s) Groundwater Encountered 1. 14' ft. 2. _____ ft. 3. _____ ft.

WELL'S STATIC WATER LEVEL 13.0 ft. below land surface measured on mo/day/yr 2-10-98

Pump test data: Well water was _____ ft. after _____ hours pumping _____ gpm

Est. Yield _____ gpm. Well water was _____ ft. after _____ hours pumping _____ gpm

Bore Hole Diameter... 8 1/2" in. to 20' ft., and _____ in. to _____ ft.

WELL WATER TO BE USED AS:

5 Public water supply	8 Air conditioning	11 Injection well
1 Domestic	3 Feedlot	6 Oil field water supply
2 Irrigation	4 Industrial	7 Lawn and garden only
		9 Dewatering
		12 Other (Specify below)
		10 Monitoring well

Was a chemical/bacteriological sample submitted to Department? Yes _____ No X; If yes, mo/day/yr sample was submitted _____

Water Well Disinfected? Yes _____ No (No)

5 TYPE OF BLANK CASING USED:

1 Steel	3 RMP (SR)	5 Wrought iron	8 Concrete tile	CASING JOINTS: Glued _____ Clamped _____
2 PVC	4 ABS	6 Asbestos-Cement	9 Other (specify below)	Welded _____
		7 Fiberglass		Threaded <u>X</u>

Blank casing diameter 2.375 in. to 10' ft., Dia _____ in. to _____ ft., Dia _____ in. to SDR 13 ft.

Casing height above land surface Flush Ht. in., weight _____ lbs./ft. Wall thickness or gauge No. Sch 40

TYPE OF SCREEN OR PERFORATION MATERIAL:

1 Steel	3 Stainless steel	5 Fiberglass	8 RMP (SR)	10 Asbestos-cement
2 Brass	4 Galvanized steel	6 Concrete tile	9 ABS	11 Other (specify) _____
				12 None used (open hole)

SCREEN OR PERFORATION OPENINGS ARE:

1 Continuous slot	3 Mill slot	5 Gauzed wrapped	8 Saw cut	11 None (open hole)
2 Louvered shutter	4 Key punched	6 Wire wrapped	9 Drilled holes	
		7 Torch cut	10 Other (specify) _____	

SCREEN-PERFORATED INTERVALS: From 20' ft. to 10' ft., From _____ ft. to _____ ft.

GRAVEL PACK INTERVALS: From 20' ft. to 8' ft., From _____ ft. to _____ ft.

6 GROUT MATERIAL: 1 Neat cement 2 Cement grout 3 Bentonite 4 Other _____

Grout Intervals: From 8' ft. to 3' ft., From 3' ft. to 0' ft., From _____ ft. to _____ ft.

What is the nearest source of possible contamination:

1 Septic tank	4 Lateral lines	7 Pit privy	10 Livestock pens	14 Abandoned water well
2 Sewer lines	5 Cess pool	8 Sewage lagoon	11 Fuel storage	15 Oil well/Gas well
3 Watertight sewer lines	6 Seepage pit	9 Feedyard	12 Fertilizer storage	16 Other (specify below)
			13 Insecticide storage	

Direction from well? Northeast How many feet? 50'

FROM	TO	LITHOLOGIC LOG	FROM	TO	PLUGGING INTERVALS
0	2	Topsoil			
2	2.5	Dk brn silty clay, moist, soft.			
2.5	3	Tan-gray silty clay, red brn mottled A/A.			
3	4	Gray/blue silty clay, moist, red brn mottled, sl. odor.			
4	10	Brn/gray Silty clay, A/A.			
10	11	Very fine sand, well sorted, sl. silty, discolored, rust brn, strong odor.			
11	15	Blue/gray sand, very fine, sl. silty, well sorted, strong odor.			
15	20	Sand, becoming wet, A/A.			

Fl mt. OK'D by Don Taylor

7 CONTRACTOR'S OR LANDOWNER'S CERTIFICATION: This water well was (1) constructed, (2) reconstructed, or (3) plugged under my jurisdiction and was completed on (mo/day/year) 2-10-98 and this record is true to the best of my knowledge and belief. Kansas Water Well Contractor's License No. 539 This Water Well Record was completed on (mo/day/yr) 3-19-98 under the business name of JB Environmental Drilling by (signature) James Beebe

OFFICE USE ONLY
T
R
EW
SEC
1/4
1/4
1/4