


1 LOCATION OF WATER WELL. Fraction NE 1/4 NE 1/4 SE 1/4 Section Number 13 Township Number T 12 S Range Number R 15 EW
 County: Shawnee

Distance and direction from nearest town or city street address of well if located within city?
3301 SW Topeka Blvd., Topeka, KS.

2 WATER WELL OWNER: Bellairre Shopping Center
 RR#, St. Address, Box # 534 S Kansas Avenue Suite 925
 City, State, ZIP Code Topeka, KS 66603
 Board of Agriculture, Division of Water Resources
 Application Number

3 LOCATE WELL'S LOCATION WITH AN "X" IN SECTION BOX:

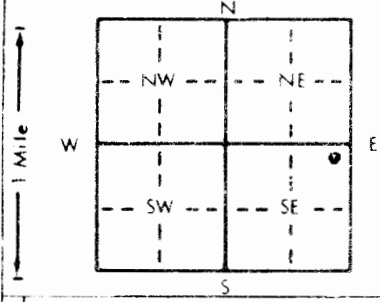

4 DEPTH OF COMPLETED WELL 15' ft. ELEVATION

Depth(s) Groundwater Encountered 1.7' ft. 2. ft. 3. ft.
 WELL'S STATIC WATER LEVEL 6.50 ft. below land surface measured on mo day yr 12-23-97
 Pump test data: Well water was ft. after hours pumping gpm
 Est. Yield gpm. Well water was ft. after hours pumping gpm
 Bore Hole Diameter: 8 1/2" in. to 15' ft. and in. to ft.
 WELL WATER TO BE USED AS:
 1 Domestic 3 Feedlot 6 Oil field water supply 9 Dewatering 12 Other (Specify below,
 2 Irrigation 4 Industrial 7 Lawn and garden only 10 Monitoring well
 Was a chemical/bacteriological sample submitted to Department? Yes No X If yes, mo day yr sample was sub-
 mitted Water Well Disinfected? Yes No

5 TYPE OF BLANK CASING USED:
 1 Steel 3 RMP (SR) 5 Wrought iron 8 Concrete tile CASING JOINTS: Glued Clamped
2 PVC 4 ABS 6 Asbestos-Cement 9 Other (specify below) Welded
 Blank casing diameter 2.375 in. to 6' ft. Dia in. to ft. Dia in. to SDR 13 ft.
 Casing height above land surface Flush Ht. in. weight lbs. ft. Wall thickness or gauge No. SCH 40

TYPE OF SCREEN OR PERFORATION MATERIAL:
 1 Steel 3 Stainless steel 5 Fiberglass 8 RMP (SR) 10 Asbestos-cement 11 Other (specify)
 2 Brass 4 Galvanized steel 6 Concrete tile 9 ABS 12 None used (open hole)

SCREEN OR PERFORATION OPENINGS ARE:
 1 Continuous slot 3 Mill slot 5 Gauzed wrapped 8 Saw cut 11 None (open hole)
 2 Louvered shutter 4 Key punched 6 Wire wrapped 9 Drilled holes

SCREEN-PERFORATED INTERVALS From 15' ft. to 5' ft. From ft. to ft.
 GRAVEL PACK INTERVALS From 15' ft. to 3' ft. From ft. to ft.

6 GROUT MATERIAL: 1 Neat cement 2 Cement grout 3 Bentonite 4 Other
 Grout intervals: From 3' ft. to 2' ft. From 2' ft. to 0' ft. From ft. to ft.
 What is the nearest source of possible contamination:
 1 Septic tank 4 Lateral lines 7 Pit privy 11 Fuel storage Four 10 Livestock pens 14 Abandoned water well
 2 Sewer lines 5 Cess pool 8 Sewage lagoon 12 Fertilizer storage 15 Oil well Gas well
 3 Watertight sewer lines 6 Seepage pit 9 Feedyard 13 Insecticide storage 16 Other (specify below)

Direction from well? North Northwest How many feet? 300'

FROM	TO	LITHOLOGIC LOG	FROM	TO	PLUGGING INTERVALS
0	.50	GRASS, TOPSOIL			
.50	10	CLAY, brn-gray, moist, sandy striations, SS frags, blk. mottled, no odor At 7, CLAY, lt. brn-yellow brn., gravel, as above At 9, CLAY, olive-yellow/brn. as above			
10	15	SHALE, lt-yellow brn., sl. moist, sandy, fissle, striated, no odor			

F.H. Okid by Don Taylor

7 CONTRACTOR'S OR LANDOWNER'S CERTIFICATION This water well was (1) constructed, (2) reconstructed, or (3) plugged under my jurisdiction and was completed on (mo/day/year) 12-23-97 and this record is true to the best of my knowledge and belief Kansas Water Well Contractor's License No 539 This Water Well Record was completed on (mo/day/yr) 2-24-98 under the business name of JB Environmental Drilling by (signature) James Belker

INSTRUCTIONS: Use typewriter or ball point pen. PLEASE PRESS FIRMLY and PRINT clearly. Please fill in blanks, underline or circle the correct answers. Send top three copies to Kansas Department of Health and Environment, Bureau of Water, Topeka, Kansas 66620-0901, Telephone: 913-296-5545. Send one to WATER WELL OWNER and retain one for your records.