

WATER WELL RECORD Form WWC-5 KSA 82a-1212

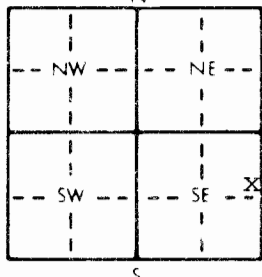
1 LOCATION OF WATER WELL: Fraction Section Number Township Number Range Number
 County: SHAWNEE SE 1/4 NE 1/4 SE 1/4 13 T 12 S R 15 **EW**

Distance and direction from nearest town or city street address of well if located within city?

813 CROIX TOPEKA, KS

MW#5

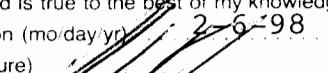
2 WATER WELL OWNER: COASTAL MART INC.
 RR#, St. Address, Box #: C/O DEBBIE HARRIS 9 GREENWAY PLAZA Board of Agriculture, Division of Water Resources
 City, State, ZIP Code: SUITE 2810 HOUSTON, TX 77046 Application Number:

3 LOCATE WELL'S LOCATION WITH AN "X" IN SECTION BOX:  4 DEPTH OF COMPLETED WELL: 15 ft. ELEVATION:
 Depth(s) Groundwater Encountered 1. ft. 2. ft. 3. ft.
 WELL'S STATIC WATER LEVEL ft. below land surface measured on mo/day yr
 Pump test data: Well water was ft. after hours pumping gpm
 Est. Yield gpm Well water was ft. after hours pumping gpm
 Bore Hole Diameter: 7 1/4 in. to 15 ft. and in. to ft.
 WELL WATER TO BE USED AS: 5 Public water supply 8 Air conditioning 11 Injection well
 1 Domestic 3 Feedlot 6 Oil field water supply 9 Dewatering 12 Other (Specify below)
 2 Irrigation 4 Industrial 7 Lawn and garden only Monitoring well
 Was a chemical/bacteriological sample submitted to Department? Yes No If yes, mo/day yr sample was sub-
 mitted Water Well Disinfected? Yes No

5 TYPE OF BLANK CASING USED: 5 Wrought iron 8 Concrete tile CASING JOINTS: Glued Clamped
 1 Steel 3 RMP (SR) 6 Asbestos-Cement 9 Other (specify below) Welded
 2 PVC 4 ABS 7 Fiberglass Threaded
 Blank casing diameter: 2 in. to 5 ft. Dia in. to ft. Dia in. to ft.
 Casing height above land surface: 0 in., weight: sched 40 lbs./ft. Wall thickness or gauge No.
 TYPE OF SCREEN OR PERFORATION MATERIAL: 7 PVC 10 Asbestos-cement
 1 Steel 3 Stainless steel 5 Fiberglass 8 RMP (SR) 11 Other (specify)
 2 Brass 4 Galvanized steel 6 Concrete tile 9 ABS 12 None used (open hole)
 SCREEN OR PERFORATION OPENINGS ARE: 5 Gauzed wrapped 8 Saw cut 11 None (open hole)
 1 Continuous slot 3 Mill slot 0.010 6 Wire wrapped 9 Drilled holes
 2 Louvered shutter 4 Key punched 7 Torch cut 10 Other (specify)
 SCREEN-PERFORATED INTERVALS: From 15 ft. to ~~7~~ 5 ft. From ft. to ft.
 From ft. to ft. From ft. to ft.
 GRAVEL PACK INTERVALS: From 15 ft. to 4 ft. From ft. to ft.
 From ft. to ft. From ft. to ft.

6 GROUT MATERIAL: 1 Neat cement 2 Cement grout 4 X3 Bentonite 4 Other
 Grout Intervals: From 2.5 ft. to -0.03 ft. From 4 ft. to 2.5 ft. From ft. to ft.
 What is the nearest source of possible contamination:
 1 Septic tank 4 Lateral lines 7 Pit privy 14 Livestock pens 14 Abandoned water well
 2 Sewer lines 5 Cess pool 8 Sewage lagoon 11 Fuel storage 15 Oil well/Gas well
 3 Watertight sewer lines 6 Seepage pit 9 Feedyard 12 Fertilizer storage 16 Other (specify below)
 13 Insecticide storage
 Direction from well? northwest How many feet? 77'

FROM	TO	LITHOLOGIC LOG	FROM	TO	PLUGGING INTERVALS
0	3	sod & topsoil			
3	8	BRN PLASTIC CLAY			
8	13	OLIVE TAN CLAY			
13	15	TAN SHALE			

7 CONTRACTOR'S OR LANDOWNER'S CERTIFICATION: This water well was () constructed, (2) reconstructed, or (3) plugged under my jurisdiction and was completed on (mo/day year) 1-21-98 and this record is true to the best of my knowledge and belief. Kansas Water Well Contractor's License No. 575 This Water Well Record was completed on (mo/day yr) 2-6-98 under the business name of KURTZ ENVIRONMENTAL SERVICE by (signature) 

INSTRUCTIONS: Use typewriter or ball point pen. PLEASE PRESS FIRMLY and PRINT clearly. Please fill in blanks, underline or circle the correct answers. Send top three copies to Kansas Department of Health and Environment, Bureau of Water, Topeka, Kansas 66620-0001. Telephone: 913 296-5545. Send one to WATER WELL OWNER and retain one for your records.