


1 LOCATION OF WATER WELL: Fraction NW 1/4 SW 1/4 SW 1/4 Section Number 29 Township Number T 12 S Range Number R 15 EW
 County: Shawnee

Distance and direction from nearest town or city street address of well if located within city?
North and East of Intersection of 6th Street and Urish Road in Topeka

2 WATER WELL OWNER: City of Topeka
 RR#, St. Address, Box #: 1115 E Poplar Board of Agriculture, Division of Water Resources
 City, State, ZIP Code: Topeka KS 66616-1389 Application Number:

3 LOCATE WELL'S LOCATION WITH AN "X" IN SECTION BOX:

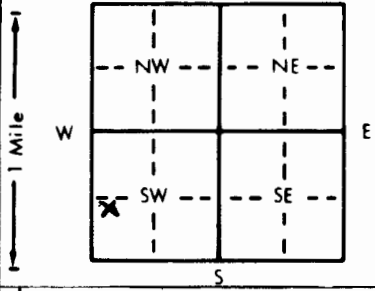

4 DEPTH OF COMPLETED WELL: 43.0 ft. ELEVATION:

Depth(s) Groundwater Encountered 1. ft. 2. ft. 3. ft.
 WELL'S STATIC WATER LEVEL 26.0 ft. below land surface measured on mo/day/yr 6/26/98
 Pump test data: Well water was ft. after hours pumping gpm
 Est. Yield gpm: Well water was ft. after hours pumping gpm
 Bore Hole Diameter 6 in. to 43.0 ft., and in. to ft.
 WELL WATER TO BE USED AS:
 1 Domestic 3 Feedlot 6 Oil field water supply 9 Dewatering 11 Injection well
 2 Irrigation 4 Industrial 7 Lawn and garden only 10 Monitoring well Piezometer
 Was a chemical/bacteriological sample submitted to Department? Yes. No X; If yes, mo/day/yr sample was submitted
 Water Well Disinfected? Yes (No)

5 TYPE OF BLANK CASING USED:
 1 Steel 3 RMP (SR) 5 Wrought iron 8 Concrete tile CASING JOINTS: Glued Clamped
 2 PVC 4 ABS 7 Fiberglass Welded
 6 Asbestos-Cement 9 Other (specify below) Threaded X

Blank casing diameter 2 in. to 32.5 ft., Dia. in. to ft., Dia. in. to ft.
 Casing height above land surface 27 in., weight 0.70 lbs/ft lbs./ft. Wall thickness or gauge No. Sch 40

TYPE OF SCREEN OR PERFORATION MATERIAL: PVC
 1 Steel 3 Stainless steel 5 Fiberglass 8 RMP (SR) 10 Asbestos-cement
 2 Brass 4 Galvanized steel 6 Concrete tile 9 ABS 11 Other (specify)
 12 None used (open hole)

SCREEN OR PERFORATION OPENINGS ARE:
 1 Continuous slot 3 Mill slot 5 Gauzed wrapped 8 Saw cut 11 None (open hole)
 2 Louvered shutter 4 Key punched 6 Wire wrapped 9 Drilled holes
 7 Torch cut 10 Other (specify)

SCREEN-PERFORATED INTERVALS: From 43.0 ft. to 32.5 ft., From ft. to ft.
 From ft. to ft., From ft. to ft.

GRAVEL PACK INTERVALS: From 43.0 ft. to 29.0 ft., From ft. to ft.
 From ft. to ft., From ft. to ft.

6 GROUT MATERIAL: 1 Neat cement 2 Cement grout 3 Bentonite 4 Other concrete
 Grout Intervals: From 29.0 ft. to 20.0 ft., From 20.0 ft. to 4.0 ft., From 4.0 ft. to 0.0 ft.

What is the nearest source of possible contamination:
 1 Septic tank 4 Lateral lines 7 Pit privy 10 Livestock pens 14 Abandoned water well
 2 Sewer lines 5 Cess pool 8 Sewage lagoon 11 Fuel storage 15 Oil well/Gas well
 3 Watertight sewer lines 6 Seepage pit 9 Feedyard 12 Fertilizer storage 16 Other (specify below) N/A
 13 Insecticide storage

Direction from well? How many feet?

FROM	TO	LITHOLOGIC LOG	FROM	TO	PLUGGING INTERVALS
0.0	11.0	Gray Brown lean clay			
11.0	36.3	Red Brown lean clay			
36.3	37.0	Limestone			
37.0	43.0	light Brown shale			

7 CONTRACTOR'S OR LANDOWNER'S CERTIFICATION: This water well was (1) constructed, (2) reconstructed, or (3) plugged under my jurisdiction and was completed on (mo/day/year) 6/26/98 and this record is true to the best of my knowledge and belief. Kansas Water Well Contractor's License No. 516 This Water Well Record was completed on (mo/day/yr) 7/2/98 under the business name of Geosystems Engineering Inc by (signature)

INSTRUCTIONS: Use typewriter or ball point pen. PLEASE PRESS FIRMLY and PRINT clearly. Please fill in blanks, underline or circle the correct answers. Send top three copies to Kansas Department of Health and Environment, Bureau of Water, Topeka, Kansas 66620-0001. Telephone: 913-296-5545. Send one to WATER WELL OWNER and retain one for your records.

OFFICE USE ONLY

T

R

EW

SEC

1

1/4

1/4