


1 LOCATION OF WATER WELL: Fraction SE 1/4 SE 1/4 NE 1/4 Section Number 36 Township Number T 12 S Range Number R 15 E/W
 County: Shawnee
 Distance and direction from nearest town or city street address of well if located within city?
416 SW 57th, Topeka, Ks.

2 WATER WELL OWNER: Pauline Farmers Coop Board of Agriculture, Division of Water Resources
 RR#, St. Address, Box #: 416 SW 57th Application Number:
 City, State, ZIP Code: Topeka, Ks. 66619

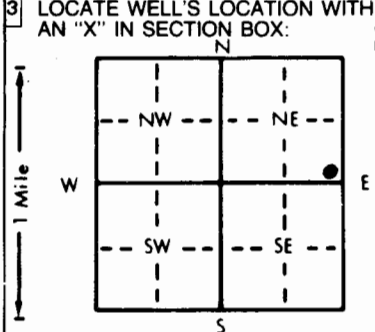

4 DEPTH OF COMPLETED WELL: 12'5" ft. ELEVATION:
 Depth(s) Groundwater Encountered 1 5.0 ft. 2. ft. 3. ft.
 WELL'S STATIC WATER LEVEL 4.91 ft. below land surface measured on mo/day/yr 2-26-98
 Pump test data: Well water was ft. after hours pumping gpm
 Est. Yield gpm; Well water was ft. after hours pumping gpm
 Bore Hole Diameter: 8 1/2 in. to 12 ft., and in. to ft.
 WELL WATER TO BE USED AS: 5 Public water supply 8 Air conditioning 11 Injection well
 1 Domestic 3 Feedlot 6 Oil field water supply 9 Dewatering 12 Other (Specify below)
 2 Irrigation 4 Industrial 7 Lawn and garden only 10 Monitoring well
 Was a chemical/bacteriological sample submitted to Department? Yes No X If yes, mo/day/yr sample was sub-
 mitted Water Well Disinfected? Yes No

5 TYPE OF BLANK CASING USED: 5 Wrought iron 8 Concrete tile CASING JOINTS: Glued Clamped
 1 Steel 3 RMP (SR) 6 Asbestos-Cement 9 Other (specify below) Welded
2 PVC 4 ABS 7 Fiberglass Threaded X
 Blank casing diameter 2.375 in. to 2 1/2 ft., Dia in. to ft., Dia in. to SDR 13 ft.
 Casing height above land surface Flush Mt. in., weight lbs./ft. Wall thickness or gauge No. SC# 40
 TYPE OF SCREEN OR PERFORATION MATERIAL: 7 PVC 10 Asbestos-cement
 1 Steel 3 Stainless steel 5 Fiberglass 8 RMP (SR) 11 Other (specify)
 2 Brass 4 Galvanized steel 6 Concrete tile 9 ABS 12 None used (open hole)
 SCREEN OR PERFORATION OPENINGS ARE: 5 Gauzed wrapped 8 Saw cut 11 None (open hole)
 1 Continuous slot 3 Mill slot 6 Wire wrapped 9 Drilled holes
 2 Louvered shutter 4 Key punched 7 Torch cut 10 Other (specify)
 SCREEN-PERFORATED INTERVALS: From 12 1/2 ft. to 2 1/2 ft., From ft. to ft.
 GRAVEL PACK INTERVALS: From 12 1/2 ft. to 2 ft., From ft. to ft.

6 GROUT MATERIAL: 1 Neat cement 2 Cement grout 3 Bentonite 4 Other
 Grout Intervals: From 2' ft. to 1' ft., From 1' ft. to 0' ft., From ft. to ft.
 What is the nearest source of possible contamination: 3 10 Livestock pens 14 Abandoned water well
 1 Septic tank 4 Lateral lines 7 Pit privy 2 11 Fuel storage 15 Oil well/Gas well
 2 Sewer lines 5 Cess pool 8 Sewage lagoon 12 Fertilizer storage 16 Other (specify below)
 3 Watertight sewer lines 6 Seepage pit 9 Feedyard 13 Insecticide storage
 Direction from well? South & East How many feet? 50'

FROM	TO	LITHOLOGIC LOG	FROM	TO	PLUGGING INTERVALS
0	1	Gravel, clay, wood.			
1	2.5	Olive brn to olive green silty fat clay, moist, strong odor.			
2.5	5	Brn to gray silty fat clay becoming reddish brn w/ gray mottling, iron oxides & blk mottling, moist, slight odor.			
5	7	A/A, though very moist, btm lightly discolored & wet, Limestone at 7'			
7	12.5	Tan-Brown-orange Brn clay w/ls, r. gravelly, wet, fall odor			

7 CONTRACTOR'S OR LANDOWNER'S CERTIFICATION: This water well was (1) constructed (2) reconstructed, or (3) plugged under my jurisdiction and was completed on (mo/day/year) 2-19-98 and this record is true to the best of my knowledge and belief. Kansas Water Well Contractor's License No. 539 This Water Well Record was completed on (mo/day/yr) 3-18-98 under the business name of JB Environmental Drilling by (signature) James Beeber

OFFICE USE ONLY
T
R
EW
SEC.