


2

1 LOCATION OF WATER WELL: Fraction SE 1/4 SE 1/4 NE 1/4 Section Number 36 Township Number T 12 S Range Number R 15 EW
 County: Shawnee

Distance and direction from nearest town or city street address of well if located within city?
416 SW 57th, Topeka, Ks.

2 WATER WELL OWNER: Pauline Farmers Coop
 RR#, St. Address, Box #: 416 SW 57th Board of Agriculture, Division of Water Resources
 City, State, ZIP Code: Topeka, Ks. 66619 Application Number:

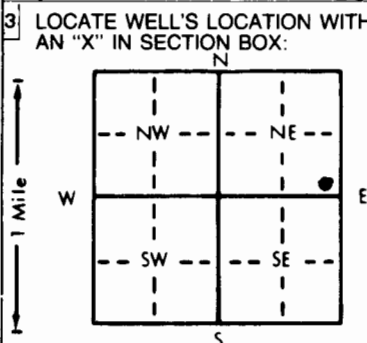

4 DEPTH OF COMPLETED WELL 14' ft. ELEVATION:
 Depth(s) Groundwater Encountered 12.3' ft. 2. ft. 3. ft.
 WELL'S STATIC WATER LEVEL 12.3' ft. below land surface measured on mo/day/yr 2-26-98
 Pump test data: Well water was ft. after hours pumping gpm
 Est. Yield gpm; Well water was ft. after hours pumping gpm
 Bore Hole Diameter 8 1/2" in. to 4" ft., and in. to ft.
 WELL WATER TO BE USED AS:
 1 Domestic 3 Feedlot 6 Oil field water supply 9 Dewatering 12 Other (Specify below)
 2 Irrigation 4 Industrial 7 Lawn and garden only 10 Monitoring well
 Was a chemical/bacteriological sample submitted to Department? Yes No X; If yes, mo/day/yr sample was submitted
 Water Well Disinfected? Yes No X

5 TYPE OF BLANK CASING USED:
 1 Steel 3 RMP (SR) 5 Wrought iron 8 Concrete tile CASING JOINTS: Glued Clamped
2 PVC 4 ABS 6 Asbestos-Cement 9 Other (specify below) Welded
 7 Fiberglass Threaded X
 Blank casing diameter 2.375 in. to 4' ft., Dia in. to ft., Dia in. to SDR 13 ft.
 Casing height above land surface Flush Mt. in., weight lbs./ft. Wall thickness or gauge No. SCH 40
 TYPE OF SCREEN OR PERFORATION MATERIAL:
 1 Steel 3 Stainless steel 5 Fiberglass 8 RMP (SR) 10 Asbestos-cement 11 Other (specify)
 2 Brass 4 Galvanized steel 6 Concrete tile 9 ABS 12 None used (open hole)
 SCREEN OR PERFORATION OPENINGS ARE:
 1 Continuous slot 3 Mill slot 5 Gauzed wrapped 8 Saw cut 11 None (open hole)
 2 Louvered shutter 4 Key punched 6 Wire wrapped 9 Drilled holes
 7 Torch cut 10 Other (specify)
 SCREEN-PERFORATED INTERVALS: From 14' ft. to 4' ft., From ft. to ft.
 GRAVEL PACK INTERVALS: From 14' ft. to 3' ft., From ft. to ft.

6 GROUT MATERIAL: 1 Neat cement 2 Cement grout 3 Bentonite 4 Other
 Grout Intervals: From 3' ft. to 2' ft., From 2' ft. to 0' ft., From ft. to ft.
 What is the nearest source of possible contamination:
 1 Septic tank 4 Lateral lines 7 Pit privy 10 Livestock pens 14 Abandoned water well
 2 Sewer lines 5 Cess pool 8 Sewage lagoon 11 Fuel storage Fouler 15 Oil well/Gas well
 3 Watertight sewer lines 6 Seepage pit 9 Feedyard 12 Fertilizer storage 16 Other (specify below)
 13 Insecticide storage
 Direction from well? Southwest How many feet? 80'

FROM	TO	LITHOLOGIC LOG	FROM	TO	PLUGGING INTERVALS
0	.5	Asphalt			
.5	2.5	Dk brn. to blk. silty clay to clay, dry no odor, firm, low plasticity			
2.5	7.5	Reddish brn. clay-clay till moist, no odor with it Gray brn. mottles, low plasticity firm to stiff At 7.5-moist			
7.5	9.5	Chalky weathered limestone, dry hard fractured, crystalline			
9.5	13	Yellow brn. weathered shaley clay to shale, dry, no odor, firm with it. Gray shale stringers			<i>F.N. OK'd by Don Taylor</i>
13	14	Gray crystalline dense, hard limestone			

7 CONTRACTOR'S OR LANDOWNER'S CERTIFICATION: This water well was (1) constructed, (2) reconstructed, or (3) plugged under my jurisdiction and was completed on (mo/day/year) 2-18-98 and this record is true to the best of my knowledge and belief. Kansas Water Well Contractor's License No. 539 This Water Well Record was completed on (mo/day/yr) 3-17-98 under the business name of JB Environmental Drilling by (signature) James Biebel

OFFICE USE ONLY
T
R
EW
SEC.
1/4