


WATER WELL RECORD Form WWC-5 KSA 82a-1212

1 LOCATION OF WATER WELL: County: Shawnee	Fraction NE 1/4 NE 1/4 SE 1/4	Section Number 36	Township Number T 12 S	Range Number R 15 E/W
-----------------------------------------------------	-----------------------------------------	-----------------------------	----------------------------------	---------------------------------

Distance and direction from nearest town or city street address of well if located within city?
416 SW 57th, Topeka, Ks.

2 WATER WELL OWNER: **Pauline Farmers Coop**
 RR#, St. Address, Box #: **416 SW 57th**
 City, State, ZIP Code: **Topeka, Ks. 66619**

Board of Agriculture, Division of Water Resources
 Application Number:

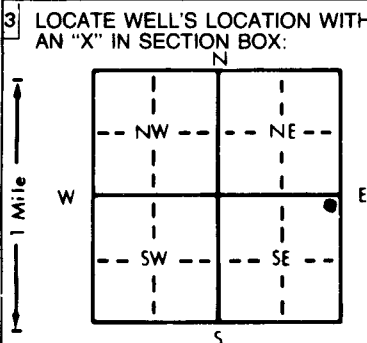

4 DEPTH OF COMPLETED WELL **13.5** ft. ELEVATION: _____

Depth(s) Groundwater Encountered **1.7'** ft. 2. _____ ft. 3. _____ ft.

WELL'S STATIC WATER LEVEL **6.70** ft. below land surface measured on mo/day/yr **2-26-98**

Pump test data: Well water was _____ ft. after _____ hours pumping _____ gpm

Est. Yield _____ gpm: Well water was _____ ft. after _____ hours pumping _____ gpm

Bore Hole Diameter **8 1/2" in. to 13 1/2"** ft., and _____ in. to _____ ft.

WELL WATER TO BE USED AS:

5 Public water supply	8 Air conditioning	11 Injection well
1 Domestic	3 Feedlot	6 Oil field water supply
2 Irrigation	4 Industrial	7 Lawn and garden only
		10 Monitoring well

Was a chemical/bacteriological sample submitted to Department? Yes _____ No **X** _____; If yes, mo/day/yr sample was submitted _____

Water Well Disinfected? Yes _____ No **(X)** _____

5 TYPE OF BLANK CASING USED:

1 Steel	3 RMP (SR)	5 Wrought iron	8 Concrete tile	CASING JOINTS: Glued _____ Clamped _____
2 PVC	4 ABS	6 Asbestos-Cement	9 Other (specify below)	Welded _____ X _____
		7 Fiberglass		Threaded _____

Blank casing diameter **2.375** in. to **3 1/2** ft., Dia _____ in. to _____ ft., Dia _____ in. to _____ ft.

Casing height above land surface **Flush** in., weight _____ lbs./ft. Wall thickness or gauge No. _____

TYPE OF SCREEN OR PERFORATION MATERIAL:

1 Steel	3 Stainless steel	5 Fiberglass	8 RMP (SR)	10 Asbestos-cement
2 Brass	4 Galvanized steel	6 Concrete tile	9 ABS	11 Other (specify) _____
				12 None used (open hole)

SCREEN OR PERFORATION OPENINGS ARE:

1 Continuous slot	3 Mill slot	5 Gauzed wrapped	8 Saw cut	11 None (open hole)
2 Louvered shutter	4 Key punched	6 Wire wrapped	9 Drilled holes	
		7 Torch cut	10 Other (specify) _____	

SCREEN-PERFORATED INTERVALS: From **13 1/2'** ft. to **3 1/2'** ft., From _____ ft. to _____ ft.

GRAVEL PACK INTERVALS: From **13 1/2'** ft. to **2'** ft., From _____ ft. to _____ ft.

6 GROUT MATERIAL: 1 Neat cement 2 **Cement grout** 3 **Bentonite** 4 Other _____

Grout Intervals: From **3'** ft. to **2'** ft., From **2'** ft. to **0'** ft., From _____ ft. to _____ ft.

What is the nearest source of possible contamination:

1 Septic tank	4 Lateral lines	7 Pit privy	10 Livestock pens	14 Abandoned water well
2 Sewer lines	5 Cess pool	8 Sewage lagoon	11 Fuel storage FUEL	15 Oil well/Gas well
3 Watertight sewer lines	6 Seepage pit	9 Feedyard	12 Fertilizer storage	16 Other (specify below)
			13 Insecticide storage	

Direction from well? **North** How many feet? **150'**

FROM	TO	LITHOLOGIC LOG	FROM	TO	PLUGGING INTERVALS
0	.5	Broken asphalt			
.5	2	Dk brn clay to silty clay, dry, firm no odor			
2	6	Olive clay with oxide staining			
6	8	Red brn clay with oxide staining, very faint odor moist to wet, low-med plasticity			
8	12	Gray-olive gray, shale with thin s.r.x stringer at 8', firm to stiff, no odor			
12	13.5	Gray limestone-hard, dense, crystalline, weathered at top 6', harder with depth, no odor			

F.H. OK'd by Don Taylor

7 CONTRACTOR'S OR LANDOWNER'S CERTIFICATION: This water well was (1) **constructed** (2) reconstructed, or (3) plugged under my jurisdiction and was completed on (mo/day/year) **2-20-98** 539 _____ and this record is true to the best of my knowledge and belief. Kansas Water Well Contractor's License No. **Environmental Drilling** This Water Well Record was completed on (mo/day/yr) **3-18-98** under the business name of _____ by (signature) *James Becker*

OFFICE USE ONLY
T
R
EW
SEC.
1/4
1/4
1/4