

WATER WELL RECORD Form WWC-5 KSA 82a-1212

1 LOCATION OF WATER WELL: County: SHAWNEE	Fraction SE 1/4 NE 1/4 SE 1/4	Section Number 8	Township Number T 12 S	Range Number R 16 EW
-----------------------------------------------------	-----------------------------------------	----------------------------	----------------------------------	---------------------------------------


Distance and direction from nearest town or city street address of well if located within city?

2701 SE CALIFORNIA AVE TOPEKA, KS

MW#9

2 WATER WELL OWNER: **COASTAL MART INC**
 RR#, St. Address, Box #: **C/O DEBBIE HARRIS**
 City, State, ZIP Code: **9 GREENWAY PLAZA HOUSTON, TX 77046**

Board of Agriculture, Division of Water Resources
 Application Number:

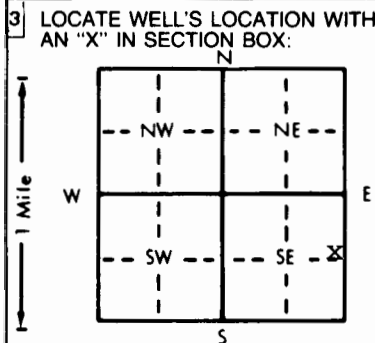

4 DEPTH OF COMPLETED WELL: **18** ft. ELEVATION: _____

Depth(s) Groundwater Encountered **18-0** ft. 2. _____ ft. 3. _____ ft.

WELL'S STATIC WATER LEVEL **18-0** ft. below land surface measured on mo/day/yr

Pump test data: Well water was _____ ft. after _____ hours pumping _____ gpm

Est. Yield _____ gpm: Well water was _____ ft. after _____ hours pumping _____ gpm

Bore Hole Diameter: **7 1/4** in. to **18** in. to _____ in. to _____ in. to _____ ft.

WELL WATER TO BE USED AS:

5 Public water supply	8 Air conditioning	11 Injection well
1 Domestic	3 Feedlot	6 Oil field water supply
2 Irrigation	4 Industrial	7 Lawn and garden only
		9 Dewatering
		12 Other (Specify below)
		10 Monitoring well

Was a chemical/bacteriological sample submitted to Department? Yes _____ No _____; If yes, mo/day/yr sample was submitted _____

Water Well Disinfected? Yes _____ No _____

5 TYPE OF BLANK CASING USED:

1 Steel	3 RMP (SR)	5 Wrought iron	8 Concrete tile	CASING JOINTS: Glued _____ Clamped _____
<input checked="" type="checkbox"/> PVC	4 ABS	6 Asbestos-Cement	9 Other (specify below)	Welded _____
		7 Fiberglass		Threaded <input checked="" type="checkbox"/>

Blank casing diameter **2** in. to **8** in. Dia _____ in. to _____ in. to _____ in. to _____ in. to _____ ft.

Casing height above land surface **0** in., weight **shed 40** lbs./ft. Wall thickness or gauge No. _____

TYPE OF SCREEN OR PERFORATION MATERIAL:

1 Steel	3 Stainless steel	5 Fiberglass	<input checked="" type="checkbox"/> PVC	10 Asbestos-cement
2 Brass	4 Galvanized steel	6 Concrete tile	8 RMP (SR)	11 Other (specify) _____
			9 ABS	12 None used (open hole)

SCREEN OR PERFORATION OPENINGS ARE:

1 Continuous slot	X3 Mill slot 0.10	5 Gauzed wrapped	8 Saw cut	11 None (open hole)
2 Louvered shutter	4 Key punched	6 Wire wrapped	9 Drilled holes	
		7 Torch cut	10 Other (specify) _____	

SCREEN-PERFORATED INTERVALS: From **18** ft. to **8** ft., From _____ ft. to _____ ft.

GRAVEL PACK INTERVALS: From **18** ft. to **6** ft., From _____ ft. to _____ ft.

6 GROUT MATERIAL: 1 Neat cement 2 Cement grout 3 Bentonite 4 Other _____

Grout Intervals: From **2** ft. to **-0.03** ft., From **6** ft. to **2** ft., From _____ ft. to _____ ft.

What is the nearest source of possible contamination:

1 Septic tank	4 Lateral lines	7 Pit privy	10 Livestock pens	14 Abandoned water well
2 Sewer lines	5 Cess pool	8 Sewage lagoon	<input checked="" type="checkbox"/> 11 Fuel storage	15 Oil well/Gas well
3 Watertight sewer lines	6 Seepage pit	9 Feedyard	12 Fertilizer storage	16 Other (specify below)
			13 Insecticide storage	

Direction from well? **south east** How many feet? **55**

FROM	TO	LITHOLOGIC LOG	FROM	TO	PLUGGING INTERVALS
0	3	GRASS & TOPSOIL			
3	8	BRN SILTY CLAY			
8	11	BRN TO TAN SILTY CLAY			
11	15	TAN MOTTELED SILTY CLAY			
15	18	WEATHERED TAN CLAY			

7 CONTRACTOR'S OR LANDOWNER'S CERTIFICATION: This water well was constructed, (2) reconstructed, or (3) plugged under my jurisdiction and was completed on (mo/day/year) **5-6-98** and this record is true to the best of my knowledge and belief. Kansas Water Well Contractor's License No. **575** This Water Well Record was completed on (mo/day/yr) **5-20-98** under the business name of **KURTZ ENVIRONMENTAL SERVICE** by (signature) _____

INSTRUCTIONS: Use typewriter or ball point pen. PLEASE PRESS FIRMLY and PRINT clearly. Please fill in blanks, underline or circle the correct answers. Send top three copies to Kansas Department of Health and Environment, Bureau of Water, Topeka, Kansas 66620-0001. Telephone: 913-296-5545. Send one to WATER WELL OWNER and retain one for your records.

OFFICE USE ONLY
T
R
EW
SEC.