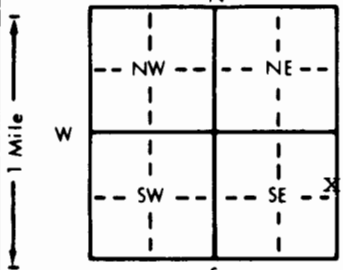


WATER WELL RECORD Form WWC-5 KSA 82a-1212

1 LOCATION OF WATER WELL: Fraction SE 1/4 NE 1/4 SE 1/4 Section Number 8 Township Number T 12 S Range Number R 16 SW  
 County: SHAWNEE  
 Distance and direction from nearest town or city street address of well if located within city? 2701 SE. CALIFORNIA AVE TOPEKA, KS MW#2

2 WATER WELL OWNER: COASTAL MART INC. 9 GREENWAY PLAZA  
 RR#, St. Address, Box # : C/O DEBBIE HARRIS Board of Agriculture, Division of Water Resources  
 City, State, ZIP Code : SUITE 2810 HOUSTON, TX 77046 Application Number:

3 LOCATE WELL'S LOCATION WITH AN "X" IN SECTION BOX:  
  
 4 DEPTH OF COMPLETED WELL: 22.5 ft. ELEVATION:  
 Depth(s) Groundwater Encountered 1. . . . . ft. 2. . . . . ft. 3. . . . . ft.  
 WELL'S STATIC WATER LEVEL . . . . . ft. below land surface measured on mo/day/yr  
 Pump test data: Well water was . . . . . ft. after . . . . . hours pumping . . . . . gpm  
 Est. Yield . . . . . gpm: Well water was . . . . . ft. after . . . . . hours pumping . . . . . gpm  
 Bore Hole Diameter: 7 1/4 in. to 22.5 . . . . . ft., and . . . . . in. to . . . . . ft.  
 WELL WATER TO BE USED AS: 5 Public water supply 8 Air conditioning 11 Injection well  
 1 Domestic 3 Feedlot 6 Oil field water supply 9 Dewatering 12 Other (Specify below)  
 2 Irrigation 4 Industrial 7 Lawn and garden only 10 Monitoring well  
 Was a chemical/bacteriological sample submitted to Department? Yes. . . . . No. . . . .; If yes, mo/day/yr sample was submitted  
 Water Well Disinfected? Yes No

5 TYPE OF BLANK CASING USED: 5 Wrought iron 8 Concrete tile CASING JOINTS: Glued . . . . . Clamped . . . . .  
 1 Steel 3 RMP (SR) 6 Asbestos-Cement 9 Other (specify below) Welded . . . . .  
 2 PVC X 4 ABS 7 Fiberglass . . . . . X Threaded . . . . .  
 Blank casing diameter 2 . . . . . in. to 12.5 . . . . . ft. Dia. . . . . in. to . . . . . ft. Dia. . . . . in. to . . . . . ft.  
 Casing height above land surface 0 . . . . . in., weight sched 40 . . . . . lbs./ft. Wall thickness or gauge No. . . . .  
 TYPE OF SCREEN OR PERFORATION MATERIAL: X 7 PVC 10 Asbestos-cement  
 1 Steel 3 Stainless steel 5 Fiberglass 8 RMP (SR) 11 Other (specify) . . . . .  
 2 Brass 4 Galvanized steel 6 Concrete tile 9 ABS 12 None used (open hole)  
 SCREEN OR PERFORATION OPENINGS ARE: 5 Gauzed wrapped 8 Saw cut 11 None (open hole)  
 1 Continuous slot X 3 Mill slot 0.10 6 Wire wrapped 9 Drilled holes  
 2 Louvered shutter 4 Key punched 7 Torch cut 10 Other (specify) . . . . .  
 SCREEN-PERFORATED INTERVALS: From 22.5 . . . . . ft. to 12.5 . . . . . ft. From . . . . . ft. to . . . . . ft.  
 GRAVEL PACK INTERVALS: From 22.5 . . . . . ft. to 10 . . . . . ft. From . . . . . ft. to . . . . . ft.

6 GROUT MATERIAL: 7 1 Neat cement X 2 Cement grout X 3 Bentonite 4 Other . . . . .  
 Grout Intervals: From 7 . . . . . ft. to -.03 . . . . . ft. From 10 . . . . . ft. to 7 . . . . . ft. From . . . . . ft. to . . . . . ft.  
 What is the nearest source of possible contamination:  
 1 Septic tank 4 Lateral lines 7 Pit privy X 11 Fuel storage 14 Abandoned water well  
 2 Sewer lines 5 Cess pool 8 Sewage lagoon 12 Fertilizer storage 15 Oil well/Gas well  
 3 Watertight sewer lines 6 Seepage pit 9 Feedyard 13 Insecticide storage 16 Other (specify below)  
 Direction from well? S How many feet? south 23'

FROM	TO	LITHOLOGIC LOG	FROM	TO	PLUGGING INTERVALS
0	6"	CONCRETE			
6"	7	BRN CLAY			
7	15	TAN TO BRN SILTY CLAY MOIST			
15	21	OLIVE TO TAN CLAY			
21	22.5	WEATHERED TAN SHALE			

7 CONTRACTOR'S OR LANDOWNER'S CERTIFICATION: This water well was (1) constructed, (2) reconstructed, or (3) plugged under my jurisdiction and was completed on (mo/day/year) 1-22-98 and this record is true to the best of my knowledge and belief. Kansas Water Well Contractor's License No. 575 This Water Well Record was completed on (mo/day/yr) 2-9-98 under the business name of KURTZ ENVIRONMENTAL SERVICE by (signature) [Signature]

OFFICE USE ONLY

T

R

EW

SEC

1/4

1/4

1/4