

1	LOCATION OF WATER WELL:	Fraction	Section Number	Township Number	Range Number
County:	<b>Shawnee</b>	<b>NE ¼ NE ¼ NW ¼</b>	<b>14</b>	<b>12</b>	<b>15-East</b>

Distance and direction from nearest town or city street address of well if located within city?

**3101 SW 29<sup>th</sup> Street, Topeka, Kansas**

2	WATER WELL OWNER: <b>Kent Lindemuth</b>	Board of Agriculture, Division of Water Resources
RR#, St. Address, Box #	<b>4350 Greenhills Place</b>	Application Number:
City, State, ZIP Code	<b>Topeka, Kansas 66618</b>	

3 MARK WELL'S LOCATON WITH AN "X" IN SECTION BOX:

4 DEPTH OF WELL **14.0** ft.

WELL'S STATIC WATER LEVEL **9.06** ft.


WELL WAS USED AS:

- |              |                              |                    |
|--------------|------------------------------|--------------------|
| 1 Domestic   | 5 Public Water Supply        | 9 Dewatering       |
| 2 Irrigation | 6 Oil Field Water Supply     | 10 Monitoring Well |
| 3 Feedlot    | 7 Lawn and Garden (domestic) | 11 Injection Well  |
| 4 Industrial | 8 Air Conditioning           | 12 Other           |

Was a chemical/bacteriological sample submitted to Department? Yes \_\_\_ No **X**

If yes, mo/day/yr sample was submitted \_\_\_\_\_

Water Well Disinfected: Yes \_\_\_ No **X**

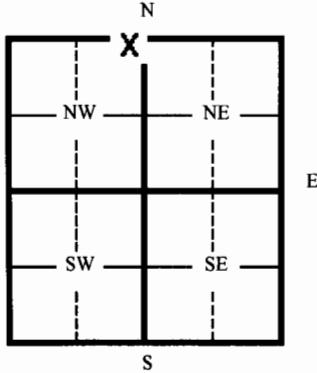

5 TYPE OF BLANK CASING USED:

1 Steel	3 RMP (SR)	5 Wrought	7 Fiberglass	9 Other (specify below)
2 PVC	4 ABC	6 Asbestos-Cement	8 Concrete Tile	

Blank casing diameter **2.375** in. Was casing pulled? Yes **X** No \_\_\_ If yes, how much? **14.0'**

Casing height above or below land surface **Unknown** in. Per approval by KDHE-BOW, well not overdrilled due to inaccessibility to drill rig.

6 GROUT PLUG MATERIAL: 1 Neat cement 2 Cement grout 3 Bentonite 4 Other **Soils/Concrete**

Grout Plug Intervals From **14.0** ft. to **3.0** ft. From **3.0** ft. to **1.0** ft. From **1.0** ft. to **0.0** ft.

What is the nearest source of possible contamination:

- |                          |                   |                         |                          |
|--------------------------|-------------------|-------------------------|--------------------------|
| 1 Septic tank            | 6 Seepage pit     | 11 Fuel storage         | 16 Other (specify below) |
| 2 Sewer lines            | 7 Pit privy       | 12 Fertilizer storage   |                          |
| 3 Watertight sewer lines | 8 Sewage lagoon   | 13 Insecticide storage  |                          |
| 4 Lateral lines          | 9 Feedyard        | 14 Abandoned water well |                          |
| 5 Cess Pool              | 10 Livestock pens | 15 Oil well/ Gas well   |                          |

Direction from well? **South-southwest** How many feet? **160**

FROM	TO	CODE	PLUGGING MATERIALS
0.0	1.0		<b>Concrete</b>
1.0	3.0		<b>Compacted soils</b>
3.0	14.0		<b>Bentonite chips</b>

7 CONTRACTOR'S OR LANDOWNER'S CERTIFICATION: This water well was plugged under my jurisdiction and was completed on (mo/day/yr) **01/05/07** and this record is true to the best of my knowledge and belief. Kansas Water Well Contractor's License No. **692** This Water Well Record was completed on (mo/day/yr) **01/08/07** under the business name of **Quad State Services, Inc.** by (signature) *[Signature]*

INSTRUCTIONS: Please fill in blanks and circle the correct answers. Send three copies to Kansas Department of Health and Environment, Bureau of Water, 1000 S W Jackson St., Ste. 420, Topeka, Kansas 66620-0001. Telephone: 785-296-3565. Send one to Water Well Owner and retain one for your records.