


1 LOCATION OF WATER WELL: Fraction **NE 1/4 NE 1/4 NW 1/4** Section Number **14** Township Number **12** Range Number **15-East**
 County: **Shawnee**

Distance and direction from nearest town or city street address of well if located within city?
3101 SW 29th Street, Topeka, Kansas

2 WATER WELL OWNER: **Kent Lindemuth**
 RR#, St. Address, Box # **4350 Greenhills Place** Board of Agriculture, Division of Water Resources
 City, State, ZIP Code : **Topeka, Kansas 66618** Application Number:

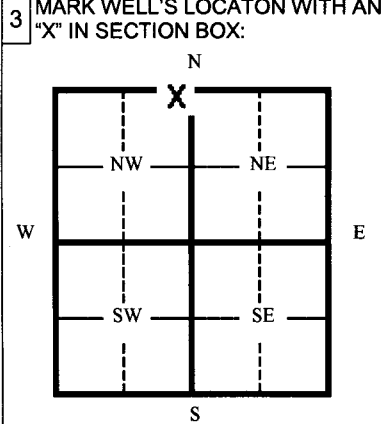

4 DEPTH OF WELL **14.5** ft.
 WELL'S STATIC WATER LEVEL **7.16** ft.
 WELL WAS USED AS:
 1 Domestic 5 Public Water Supply 9 Dewatering
 2 Irrigation 6 Oil Field Water Supply 10 Monitoring Well
 3 Feedlot 7 Lawn and Garden (domestic) 11 Injection Well
 4 Industrial 8 Air Conditioning 12 Other _____
 Was a chemical/bacteriological sample submitted to Department? Yes ___ No **X**
 If yes, mo/day/yr sample was submitted _____
 Water Well Disinfected: Yes ___ No **X**

5 TYPE OF BLANK CASING USED:
 1 Steel 3 RMP (SR) 5 Wrought 7 Fiberglass 9 Other (specify below)
 2 PVC 4 ABC 6 Asbestos-Cement 8 Concrete Tile
 Blank casing diameter **2.375** in. Was casing pulled? Yes **X** No ___ If yes, how much? **14.5'**
 Casing height above or below land surface **Unknown** in. **Overdrilled well to 14.5'**

6 GROUT PLUG MATERIAL: 1 Neat cement 2 Cement grout 3 Bentonite 4 Other **Soils**
 Grout Plug Intervals From **14.5** ft. to **3.0** ft. From **3.0** ft. to **0.0** ft. From ___ ft. to ___ ft.
 What is the nearest source of possible contamination:
 1 Septic tank 6 Seepage pit 11 Fuel storage 16 Other (specify below)
 2 Sewer lines 7 Pit privy 12 Fertilizer storage
 3 Watertight sewer lines 8 Sewage lagoon 13 Insecticide storage
 4 Lateral lines 9 Feedyard 14 Abandoned water well
 5 Cess Pool 10 Livestock pens 15 Oil well/ Gas well
 Direction from well? **Southwest** How many feet? **120**

FROM	TO	CODE	PLUGGING MATERIALS
0.0	3.0		Compacted soils
3.0	14.5		Bentonite chips

7 CONTRACTOR'S OR LANDOWNER'S CERTIFICATION: This water well was plugged under my jurisdiction and was completed on (mo/day/yr) **01/05/07** and this record is true to the best of my knowledge and belief. Kansas Water Well Contractor's License No. **692** This Water Well Record was completed on (mo/day/yr) **01/08/07** under the business name of **Quad State Services, Inc.** by (signature) _____

INSTRUCTIONS: Please fill in blanks and circle the correct answers. Send three copies to Kansas Department of Health and Environment, Bureau of Water, 1000 S W Jackson St., Ste. 420, Topeka, Kansas 66620-0001. Telephone: 785-296-3565. Send one to Water Well Owner and retain one for your records.