


1 LOCATION OF WATER WELL: Fraction NE¹/₄ NE¹/₄ NE¹/₄ Section Number 9 Township Number 12 Range Number 15 E
 County: Shawnee

Distance and direction from nearest town or city street address of well if located within city? (Former Wendy's Parking Lot)
N 150' NW of the intersection of 21st Street & Fairlawn, in Topeka, KS

2 WATER WELL OWNER: Amaco Oil Co
 RR #, St. Address, Box #: 21512 Fairlawn Board of Agriculture, Division of Water Resources
 City, State, ZIP Code: Topeka, KS Application Number:

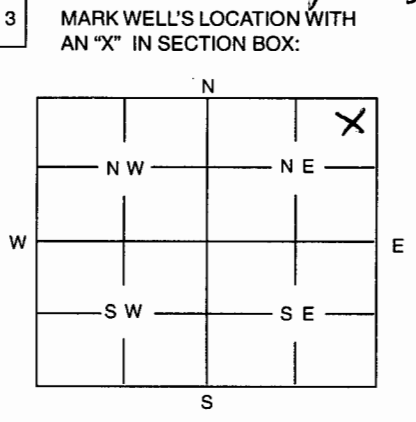

4 DEPTH OF WELL 26.57 ft
 WELL'S STATIC WATER LEVEL 18.37 ft
 WELL WAS USED AS:
 1 Domestic 5 Public Water Supply 9 Dewatering
 2 Irrigation 6 Oil Field Water Supply 10 Monitoring Well
 3 Feedlot 7 Domestic (Lawn & Garden) 11 Injection Well
 4 Industrial 8 Air Conditioning 12 Other
 Was a chemical / bacteriological sample submitted to Department? Yes No X
 If yes, mo/day/yr sample was submitted
 Water Well Disinfected: Yes No X

5 TYPE OF BLANK CASING USED:
 1 Steel 3 RMP (SR) 5 Wrought 7 Fiberglass 9 Other (Specify below)
2 PVC 4 ABS 6 Asbestos-Cement 8 Concrete Tile
 Blank casing diameter 2 in. Was casing pulled? Yes No X If yes, how much
 Casing height above or below land surface -12 in.

6 GROUT PLUG MATERIAL: 1 Neat cement 2 Cement grout 3 Bentonite 4 Other
 Grout Plug Intervals: From 26.57 ft. to 10 ft., From ft. to ft., From to ft.
 What is the nearest source of possible contamination:
 1 Septic tank 6 Seepage pit 11 Fuel storage 16 Other (specify below)
 2 Sewer lines 7 Pit privy 12 Fertilizer storage
 3 Watertight sewer lines 8 Sewage lagoon 13 Insecticide storage
 4 Lateral lines 9 Feedyard 14 Abandoned water well
 5 Cess Pool 10 Livestock pens 15 Oil well/Gas well
 Direction from well? How many feet?

FROM	TO	PLUGGING MATERIALS
<u>26.37</u>	<u>0</u>	<u>hydrated bentonite chips</u>

An attempt to pull the top 3' of casing was unsuccessful because concrete surrounded the casing to at least 3' depth.

7 CONTRACTOR'S OR LANDOWNER'S CERTIFICATION: This water well was plugged under my jurisdiction and was completed on (mo/day/year) 3/2/07 and this record is true to the best of my knowledge and belief. Kansas Water Well Contractor's License No. 749 This Water Well Record was completed on (mo/day/year) 3/5/07 under the business name of TCC Contract by (signature) [Signature]

INSTRUCTIONS: Use typewriter or ball point pen. Please press firmly and print clearly. Please fill in blanks, underline or circle the correct answers. Send top three copies to Kansas Department of Health and Environment, Bureau of Water, Topeka, Kansas 66620-0001. Telephone: 785/296-3565. Send one to Water Well Owner and retain one for your records.