WATER WELL RECORD Form WWC-5 KSA 82a-1212 ID No. MW-5

1 LOCATION OF WATER WELL:	Fraction	Section Number	Township Number	Range Number
County: Shawnee	NW ¼ NE ¼ NE ¼	11	T 12 S	R 15 E/W

Distance and direction from nearest town or city street address of well if located within city?
2619 SW 21st Street, Topeka, Kansas

2 WATER WELL OWNER: Kwik Shop, Inc.
RR#, St. Address, Box # : 734 E. 4th Avenue
City, State, ZIP Code : Hutchinson, Kansas 67504

Board of Agriculture, Division of Water Resources
Application Number:

3 LOCATE WELL'S LOCATON WITH AN "X" IN SECTION BOX:

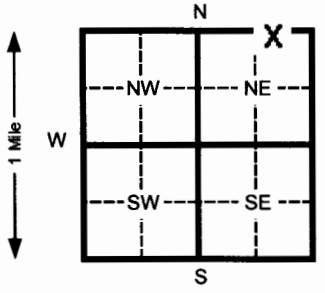

4 DEPTH OF COMPLETED WELL 17.5 ft. ELEVATION:
Depth(s) Groundwater Encountered 1 11.5 ft. 2 ____ ft. 3 ____ ft.
WELL'S STATIC WATER LEVEL 10.35 ft. below land surface measured on mo/day/yr 08/28/07
Pump test data: Well water was ____ ft. after ____ hours pumping ____ gpm
Est. Yield NA gpm: Well water was ____ ft. after ____ hours pumping ____ gpm
Bore Hole Diameter 8.5 in. to 17.5 ft. and ____ in. to ____ ft.
WELL WATER TO BE USED AS: 1 Domestic 2 Irrigation 3 Feed lot 4 Industrial 5 Public water supply 6 Oil field water supply 7 Lawn and garden (domestic) 8 Air conditioning 9 Dewatering 10 Monitoring well 11 Injection well 12 Other (Specify below)
Was a chemical/bacteriological sample submitted to Department? Yes ____ No X If yes, mo/day/yr sample was submitted
Water Well Disinfected? Yes ____ No X

5 TYPE OF BLANK CASING USED: 1 Steel 2 PVC 3 RMP (SR) 4 ABS 5 Wrought Iron 6 Asbestos-Cement 7 Fiberglass 8 Concrete tile 9 Other (specify below)
CASING JOINTS: Glued ____ Clamped ____ Welded ____ Threaded X
Blank casing diameter 2.375 in. to 7.5 ft., Dia ____ in. to ____ ft., Dia ____ in. to ____ ft.
Casing height above land surface Flush Mount in., weight ____ lbs./ft. Wall thickness or gauge No. Schedule 40
TYPE OF SCREEN OR PERFORATION MATERIAL: 1 Steel 2 Brass 3 Stainless steel 4 Galvanized steel 5 Fiberglass 6 Concrete tile 7 PVC 8 RMP (SR) 9 ABS 10 Asbestos-cement 11 Other (specify) ____ 12 None used (open hole)
SCREEN OR PERFORATION OPENINGS ARE: 1 Continuous slot 2 Louvered shutter 3 Mill slot 4 Key punched 5 Gauzed wrapped 6 Wire wrapped 7 Torch cut 8 Saw cut 9 Drilled holes 10 Other (specify) ____ 11 None (open hole)
SCREEN-PERFORATED INTERVALS: From 17.5 ft. to 7.5 ft. From ____ ft. to ____ ft.
From ____ ft. to ____ ft. From ____ ft. to ____ ft.
GRAVEL PACK INTERVALS: From 17.5 ft. to 5.5 ft. From ____ ft. to ____ ft.
From ____ ft. to ____ ft. From ____ ft. to ____ ft.

6 GROUT MATERIAL: 1 Neat cement 2 Cement grout 3 Bentonite 4 Other ____
Grout Intervals From 0.0 ft. to 1.0 ft. From 1.0 ft. to 5.5 ft. From ____ ft. to ____ ft.
What is the nearest source of possible contamination:
1 Septic tank 2 Sewer lines 3 Watertight sewer lines 4 Lateral lines 5 Cess pool 6 Seepage pit 7 Pit privy 8 Sewage lagoon 9 Feedyard 10 Livestock pens 11 Fuel storage 12 Fertilizer storage 13 Insecticide storage 14 Abandoned water well 15 Oil well/ Gas well 16 Other (specify below) ____
Direction from well? Northwest How many feet? 165

FROM	TO	CODE	LITHOLOGIC LOG
0.0	0.5		Asphalt
0.5	5.0		Black silty clay, very firm, moist
5.0	6.0		Gray-black sandy siltstone
6.0	8.0		Brown-red sandy clay, firm, moist
8.0	15.0		Red brown silty clay, laminated gray, very firm, moist
15.0	15.5		Gray silty clay, very firm, moist
15.5	16.0		Gray sandy clay, firm, moist
16.0	17.5		Red brown sand, fine grained, well sorted, moist-wet
			Exception to K.A.R. 28-30-6(b) (1) and (e) approved by D. Taylor, KDHE-BOW.

7 CONTRACTOR'S OR LANDOWNER'S CERTIFICATION: This water well was (1) constructed, (2) reconstructed, or (3) plugged under my jurisdiction and was completed on (mo/day/yr) 08/21/07 and this record is true to the best of my knowledge and belief. Kansas Water Well Contractor's License No. 692 This Water Well Record was completed on (mo/day/yr) 09/17/07 under the business name of Quad State Services, Inc. by (signature)

INSTRUCTIONS:. Please fill in blanks and circle the correct answers. Send three copies to Kansas Department of Health and Environment, Bureau of Water, 1000 S.W Jackson St., Ste. 420, Topeka, Kansas 66612-1367. Telephone: 913-296-5545. Send one to WATER WELL OWNER and retain one for your records.

OFFICE USE ONLY T R SEC