


1 LOCATION OF WATER WELL:	Fraction	Section Number	Township Number	Range Number
County: Shawnee	SE ¼ SE ¼ NE ¼	13	12	15-East

Distance and direction from nearest town or city street address of well if located within city?

330, Topeka Blvd, Topeka Kansas

2 WATER WELL OWNER: Jiffy Lube	Board of Agriculture, Division of Water Resources
RR#, St. Address, Box # 3201 Gilham Plaza	Application Number:
City, State, ZIP Code : Kansas City, MO	

3 MARK WELL'S LOCATON WITH AN "X" IN SECTION BOX:

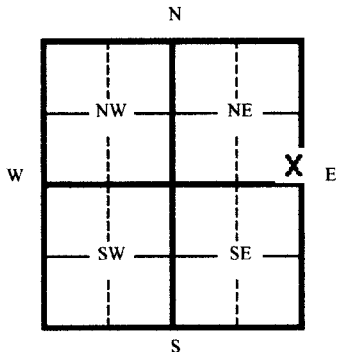

4 DEPTH OF WELL 15.0 ft.

WELL'S STATIC WATER LEVEL 5.00 ft.

WELL WAS USED AS:

- | | | |
|--------------|------------------------------|-------------------|
| 1 Domestic | 5 Public Water Supply | 8 Dewatering |
| 2 Irrigation | 6 Oil Field Water Supply | 9 Monitoring Well |
| 3 Feedlot | 7 Lawn and Garden (domestic) | 11 Injection Well |
| 4 Industrial | 8 Air Conditioning | 12 Other |

Was a chemical/bacteriological sample submitted to Department? Yes ___ No X

If yes, mo/day/yr sample was submitted _____

Water Well Disinfected: Yes ___ No X

5 TYPE OF BLANK CASING USED:

1 Steel	3 RMP (SR)	5 Wrought	7 Fiberglass	9 Other (specify below)
2 PVC	4 ABC	6 Asbestos-Cement	8 Concrete Tile	

Blank casing diameter 2.375 in. Was casing pulled? Yes X No ___ If yes, how much? 3'

Casing height above or below land surface Unknown in. **Overdrilled well to 3"**

6 GROUT PLUG MATERIAL: 1 Neat cement 2 Cement grout 3 Bentonite 4 Other Asphalt

Grout Plug Intervals From 15.0 ft. to 3.0 ft. From 3.0 ft. to 1.0 ft. From 1.0 ft. to 0.0 ft.

What is the nearest source of possible contamination:

- | | | | |
|--------------------------|-------------------|--------------------------|--------------------------|
| 1 Septic tank | 6 Seepage pit | 11 Fuel storage (former) | 16 Other (specify below) |
| 2 Sewer lines | 7 Pit privy | 12 Fertilizer storage | |
| 3 Watertight sewer lines | 8 Sewage lagoon | 13 Insecticide storage | |
| 4 Lateral lines | 9 Feedyard | 14 Abandoned water well | |
| 5 Cess Pool | 10 Livestock pens | 15 Oil well/ Gas well | |

Direction from well? N/A How many feet? 0

FROM	TO	CODE	PLUGGING MATERIALS
0.0	1.0		Asphalt
1.0	3.0		Soils
3.0	15.0		Bentonite chips

7 CONTRACTOR'S OR LANDOWNER'S CERTIFICATION: This water well was plugged under my jurisdiction and was completed on (mo/day/yr) 04/23/08 and this record is true to the best of my knowledge and belief. Kansas Water Well Contractor's License No. 692 This Water Well Record was completed on (mo/day/yr) 05/05.08 under the business name of Quad State Services, Inc. by (signature) *[Signature]*

INSTRUCTIONS: Please fill in blanks and circle the correct answers. Send three copies to Kansas Department of Health and Environment, Bureau of Water, 1000 S W Jackson St., Ste. 420, Topeka, Kansas 66620-0001. Telephone: 785-296-3565. Send one to Water Well Owner and retain one for your records.