


1	LOCATION OF WATER WELL:	Fraction	Section Number	Township Number	Range Number
County:	Shawnee	¼ SE ¼ SW ¼	23	125	15E E/W

Distance and direction from nearest town or city street address of well if located within city?
 3232 SW 45th St., Topeka, KS 66109

2	WATER WELL OWNER: F & L Enterprises Inc.	RR #, St. Address, Box #: 4431 SE California Ave.	Board of Agriculture, Division of Water Resources
		City, State, ZIP Code : Topeka, KS 66609	Application Number:

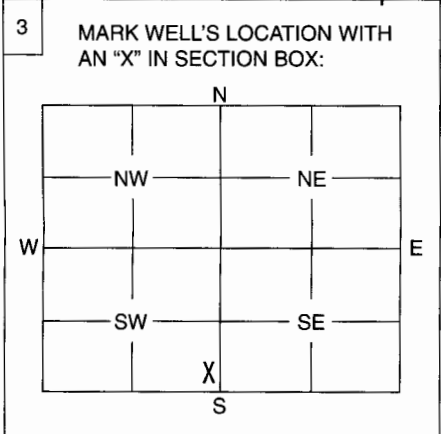

4	DEPTH OF WELL 23 ft.
	WELL'S STATIC WATER LEVEL 7'-0" ft.
	WELL WAS USED AS:
	<input checked="" type="checkbox"/> 1 Domestic <input type="checkbox"/> 2 Irrigation <input type="checkbox"/> 3 Feedlot <input type="checkbox"/> 4 Industrial <input type="checkbox"/> 5 Public Water Supply <input type="checkbox"/> 6 Oil Field Water Supply <input type="checkbox"/> 7 Domestic (Lawn & Garden) <input type="checkbox"/> 8 Air Conditioning <input type="checkbox"/> 9 Dewatering <input type="checkbox"/> 10 Monitoring Well <input type="checkbox"/> 11 Injection Well <input type="checkbox"/> 12 Other
	Was a chemical / bacteriological sample submitted to Department? Yes No <input checked="" type="checkbox"/>
	If yes, mo/day/yr sample was submitted
	Water Well Disinfected: Yes <input checked="" type="checkbox"/> No

5	TYPE OF BLANK CASING USED:
	1 Steel 3 RMP (SR) 5 Wrought 7 Fiberglass 9 Other (Specify below) 2 PVC 4 ABS 6 Asbestos-Cement 8 Concrete Tile Brick 7'0" Diameter
	Blank casing diameter in. Was casing pulled? Yes No If yes, how much
	Casing height above or below land surface in.

6	GROUT PLUG MATERIAL: <input checked="" type="checkbox"/> 1 Neat cement 2 Cement grout 3 Bentonite 4 Other
	Grout Plug Intervals: From ft. to ft., From ft. to ft., From to ft.
	What is the nearest source of possible contamination:
	1 Septic tank 6 Seepage pit 11 Fuel storage 16 Other (specify below) 2 Sewer lines 7 Pit privy 12 Fertilizer storage 3 Watertight sewer lines 8 Sewage lagoon 13 Insecticide storage 4 Lateral lines 9 Feedyard 14 Abandoned water well 5 Cess pool 10 Livestock pens 15 Oil well/Gas well
	Direction from well? How many feet? All septic lines & tank abandoned & removed

FROM	TO	PLUGGING MATERIALS
23'	12'	Concrete Grout
12'	0'	Compacted Dirt

7	CONTRACTOR'S OF LANDOWNER'S CERTIFICATION: This water well was plugged under my jurisdiction and was completed on (mo/day/year) 9-9-09 and this record is true to the best of my knowledge and belief. Kansas Water Well Contractor's License No. This Water Well Record was completed on (mo/day/year) under the business name of
	by (signature) <i>David G. Hemm</i> <i>Jon Sims</i>

INSTRUCTIONS: Use typewriter or ball point pen. Please press firmly and print clearly. Please fill in blanks, underline or circle the correct answers. Send top three copies to Kansas Department of Health and Environment, Bureau of Water, Geology Section, 1000 SW Jackson St., Ste. 420, Topeka, Kansas 66612-1367. Telephone: 785/296-5522. Send one to Water Well Owner and retain one for your records.