


1 LOCATION OF WATER WELL: County: <u>Shawnee</u>	Fraction <u>NE 1/4 NE 1/4 NE 1/4</u>	Section Number <u>17</u>	Township Number <u>12</u>	Range Number <u>15</u> <input checked="" type="radio"/> EW
---	---	-----------------------------	------------------------------	---

Distance and direction from nearest town or city street address of well if located within city?
HyVee Store 6011 SW 29th ; Topeka, KS.

2 WATER WELL OWNER: <u>HyVee Corporation</u>	Global Positioning Systems (decimal degrees, min. of 4 digits) Latitude: <u>39 00 50.00</u> Longitude: <u>95 45 49.06</u> Elevation: _____ Datum: _____ Data Collection Method: _____
RR#, St. Address, Box #: <u>5820 Westown Parkway</u>	
City, State ZIP Code: <u>West Des Moines, Iowa</u>	
<u>50266-8223</u>	

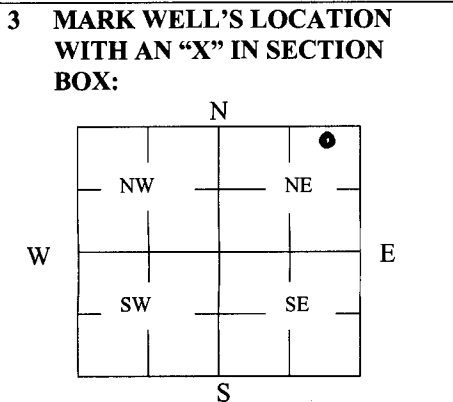

4 DEPTH OF WELL 22' ft.

WELL'S STATIC WATER LEVEL 19.45 ft

WELL WAS USED AS:

1 Domestic	5 Public Water Supply	9 Dewatering
2 Irrigation	6 Oil Field Water Supply	<input checked="" type="radio"/> 10 Monitoring
3 Feedlot	7 Domestic (Lawn & Garden)	11 Injection Well
4 Industrial	8 Air Conditioning	12 Other _____

Was a chemical/bacteriological sample submitted to Department? Yes _____ No

5 TYPE OF BLANK CASING USED:

1 Steel	3 RMP (SR)	5 Wrought	7 Fiberglass	9 Other (Specify below)
<input checked="" type="checkbox"/> 2 PVC	4 ABS	6 Asbestos-Cement	8 Concrete Tile	

Blank casing diameter 2" in. Was casing pulled? Yes No _____ If yes, how much 22'

Casing height above or below land surface _____ in.

6 GROUT PLUG MATERIAL: 1 Neat cement 2 Cement grout 3 Bentonite 4 Other Asphalt

Grout Plug Intervals: From 22' ft. to 1' ft., From 1' ft. to 0' ft., From _____ to _____ ft.

What is the nearest source of possible contamination:

1 Septic tank	6 Seepage pit	11 Fuel Storage	16 Other (specify below)
<input checked="" type="radio"/> 2 Sewer lines	7 Pit privy	12 Fertilizer storage	
3 Watertight sewer lines	8 Sewage lagoon	13 Insecticide storage	
4 Lateral lines	9 Feedyard	14 Abandoned water well	Direction from well? <u>South</u>
5 Cess pool	10 Livestock pens	15 Oil well/Gas well	How many feet? <u>20'</u>

FROM	TO	PLUGGING MATERIALS	FROM	TO	PLUGGING MATERIALS
		<u>Flush Mt. Manway was removed</u>			
		<u>2" PVC pipe was pulled out to 22' (TD)</u>			
		<u>Bentonite from 22'-1' Asphalt 1'-0'</u>			

7 CONTRACTOR'S OR LANDOWNER'S CERTIFICATION: This water well was plugged under my jurisdiction and was completed on (mo/day/year) 10/3/13 and this record is true to the best of my knowledge and belief. Kansas Water Well Contractor's License No. 732. This Water Well Record was completed on (mo/day/year) 10/14/13 under the business name of JB Environmental by (signature) James Becker

INSTRUCTIONS: Use typewriter or ballpoint pen. Please press firmly and print clearly. Please fill in blanks, underline or circle the correct answers. Send top three copies to Kansas Department of Health and Environment, Bureau of Water, Geology Section, 1000 SW Jackson St., Ste. 420, Topeka, Kansas 66612-1367. Telephone: 785/296-5522. Send one to Water Well Owner and retain one for your records. Visit us at <http://www.kdheks.gov/geo/waterwells>.