

**WATER WELL RECORD**

**Form WWC-5**

Division of Water  
Resources App. No.


Well ID

**MW5R**

Original Record     Correction     Change in Well Use

**1 LOCATION OF WATER WELL:** County Shawnee Fraction NE ¼ SE ¼ NE ¼ NE ¼ Section Number 24 Township Number T 12 S Range Number R 15 E   W

**2 WELL OWNER:** Last Name: Ed Bozarth First: Chevrolet Street or Rural Address where well is located (if unknown, distance and direction from nearest town or intersection): 3731 SW Topeka Blvd., Topeka KS  
Business: Ed Bozarth Chevrolet, Inc. If at owner's address, check here:   
Address: 3731 SW Topeka Blvd  
City: Topeka State: KS ZIP: \_\_\_\_\_

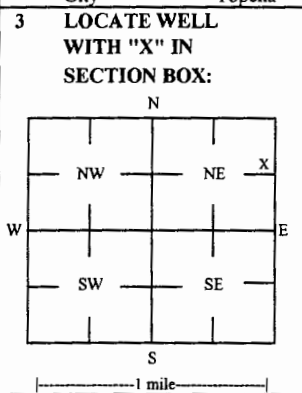

**4 DEPTH OF COMPLETED WELL:** 6.75 ft  
Depth(s) Groundwater Encountered: 1) \_\_\_\_\_ ft  
2) \_\_\_\_\_ ft 3) \_\_\_\_\_ ft, or 4)  Dry Well  
WELL'S STATIC WATER LEVEL: 4.43 ft.  
 below land surface, measured on (mo-day-yr) 8/2/2016  
 above land surface, measured on (mo-day-yr) \_\_\_\_\_  
Pump test data: Well water was \_\_\_\_\_ ft  
after \_\_\_\_\_ hours pumping \_\_\_\_\_ gpm  
Water well was \_\_\_\_\_ ft  
after \_\_\_\_\_ hours pumping \_\_\_\_\_ gpm  
Estimated Yield: \_\_\_\_\_ gpm  
Bore Hole Diameter: 7.25 in to \_\_\_\_\_ ft, and \_\_\_\_\_ in to \_\_\_\_\_ ft

**5 Latitude:** 38.99816 (decimal degrees)  
**Longitude:** 95.68844 (decimal degrees)  
Horizontal Datum:  WGS 84  NAD 83  NAD 27  
Source for Latitude/Longitude: \_\_\_\_\_  
 GPS (unit make/model: \_\_\_\_\_)  
(WAAS enabled?  Yes  No)  
 Land Survey  Topographic Map  
 Online Mapper

**6 Elevation:** 1010.26 ft  Ground Level  TOC  
Source:  Land Survey  GPS  Topographic Map  
 Other \_\_\_\_\_

**7 WELL WATER TO BE USED AS:**

1 Domestic:  Household  Lawn & Garden  Livestock  Irrigation  Feedlot  Industrial

2  Public Water Supply: well ID \_\_\_\_\_  
3  Dewatering: how many wells? \_\_\_\_\_  
4  Aquifer Recharge: well ID \_\_\_\_\_  
5  Monitoring: well ID MW5R  
6 Environmental Remediation: well ID \_\_\_\_\_  
7 Air Sparge  Soil Vapor Extractor  Recovery  Injection

8  Oil Field Water Supply: lease \_\_\_\_\_  
9 Test Hole: well ID \_\_\_\_\_  
10 Cased  Uncased  Geotechnical  
11 Geothermal: How many bores? \_\_\_\_\_  
a) Closed Loop  Horizontal  Vertical  
b) Open Loop  Surface Discharge  Inj. of Water  
12 Other (specify): \_\_\_\_\_

Was a chemical/bacteriological sample submitted to KDHE?  Yes  No If yes, date sample was submitted: \_\_\_\_\_  
Water well disinfected?  Yes  No

**8 TYPE OF CASING USED:**  Steel  PVC  Other \_\_\_\_\_ CASING JOINTS:  Glued  Clamped  Welded  Threaded  
Casing diameter 2 in. to 3 ft, Diameter \_\_\_\_\_ in. to \_\_\_\_\_ ft, Diameter \_\_\_\_\_ in. to \_\_\_\_\_ ft,  
Casing height above land surface -0.30 in. Weight \_\_\_\_\_ lbs./ft. Well thickness or gauge No \_\_\_\_\_  
TYPE OF SCREEN OR PERFORATION MATERIAL:  
 Steel  Stainless Steel  Fiberglass  PVC  Other (Specify) \_\_\_\_\_  
 Brass  Galvanized Steel  Concrete tile  None used (open hole)  
SCREEN OR PERFORATION OPENINGS ARE:  
 Continuous Slot  Mill Slot  Gauze Wrapped  Torch Cut  Drilled Holes  Other (Specify) \_\_\_\_\_  
 Louvered Shutter  Key Punched  Wire Wrapped  Saw Cut  None (Open Hole)  
SCREEN-PERFORATED INTERVALS: From 3 ft. to 6.75 ft, From \_\_\_\_\_ ft. to \_\_\_\_\_ ft, From \_\_\_\_\_ ft. to \_\_\_\_\_ ft,  
GRAVEL PACK INTERVALS: From 2 ft. to 7.5 ft, From \_\_\_\_\_ ft. to \_\_\_\_\_ ft, From \_\_\_\_\_ ft. to \_\_\_\_\_ ft,

**9 GROUT MATERIAL:**  Neat cement  Cement grout  Bentonite  Other Asphalt: 0-0.1'; Concrete: 0.1-0.7'  
Grout intervals: From 0.7 ft. to 2 ft, From \_\_\_\_\_ ft. to \_\_\_\_\_ ft, From \_\_\_\_\_ ft. to \_\_\_\_\_ ft,

**Nearest source of possible contamination:**

Septic Tank  Lateral Lines  Pit Privy  Livestock Pens  Insecticide Storage  
 Sewer Lines  Cess Pool  Sewage Lagoon  Fuel Storage  Abandoned Water Well  
 Watertight Sewer Lines  Seepage Pit  Feedyard  Fertilizer Storage  Oil Well / Gas Well  
 Other (Specify) \_\_\_\_\_  
Direction from well? E Distance from well? ~70 ft

10 FROM	TO	LITHOLOGIC LOG	FROM	TO	LITHO. LOG (cont.) or PLUGGING INTERVALS
0	0.1	Asphalt			
0.1	0.7	Concrete			
0.7	1	Dark brown w/ nodules, silty clay			
1	5.5	Tan gray, silty clay			
5.5	7.5	Limestone			

Notes: KDHE ID: Ed Bozarth Chevrolet, Inc.; U4-089-01163

**11 CONTRACTOR'S OR LANDOWNER'S CERTIFICATION:** This water well was  constructed,  reconstructed, or  plugged under my jurisdiction and was completed on (mo-day-year) 8/2/16 and this record is true to the best of my knowledge and belief. Kansas Water Well Contractor's License No 757 This Water Well Record was completed on (mo-day-year) 8/18/16 under the business name of Larsen & Associates, Inc. Signature \_\_\_\_\_

Mail 1 white copy along with a fee of \$5.00 for each constructed well to: Kansas Department of Health and Environment, Bureau of Water, GWTS Section, 1000 SW Jackson St., Suite 420, Topeka, Kansas 66612-1367. Mail one to Water Well Owner and retain one for your records. Telephone 785-296-5524.

~~RGS COPY~~

**DENNIS L HANDKE**

1820 NW 59th Terrace  
TOPEKA, KANSAS 66618  
785-286-4047 Home  
785-286-1990 Fax

Jessica Chapman  
Larsen & Associates  
1311 E. 25<sup>th</sup> Street, Suite B  
Lawrence, Kansas, 66046

August 15, 2016

RE: Monitor Well Elevation Survey  
3731 S. Topeka Blvd., Topeka, Kansas

Proj. 16-000  
Ed Bozarth Chevrolet, Inc.  
U4-089-01163

Bench Mark: X cut on top of concrete curb at the East edge of parking lot, 21.7 feet West of curb on Topeka Blvd., and 94 feet North of centerline of SW 38<sup>th</sup> Street.  
Elev: 1009.20      North 4449.03      West 65.55      (from SE Cor. Sec. 24-12-15E)

MW-5R      rim      1010.56      North      4360.45      NE1/4,SE1/4,NE1/4,NE1/4  
             top pipe      1010.26      West      211.57      Lat= 38.99816 Long = 95.68844

Elevation derived from existing project.

Lat & Long derived from Topeka 7.5 Quad Map WSG84.

If you have any questions, please feel free to call me. Thank you for the opportunity to be of service to you.

Dennis L Handke PLS

