


-revised-

WATER WELL PLUGGING RECORD Form WWC-5P KSA 82a-1212 ID NO. MW-11

1 LOCATION OF WATER WELL: SHAWNEE Fraction SW ¼ SW ¼ SW ¼ Section Number 10 Township Number T 12 S Range Number R 15 E

Distance and direction from nearest town or city street address of well if located within city?
29TH AND FAIRLAWN RD, TOPEKA, KS

2 WATER WELL OWNER: THOMAS BINKLEY
RR#, St. Address, Box #: 2319 SW TERRACE #24
City, State ZIP Code: TOPEKA, KS 66611
Global Positioning Systems (decimal degrees, min. of 4 digits)
Latitude: _____
Longitude: _____
Elevation: 948.72 _____
Datum: _____
Data Collection Method: _____

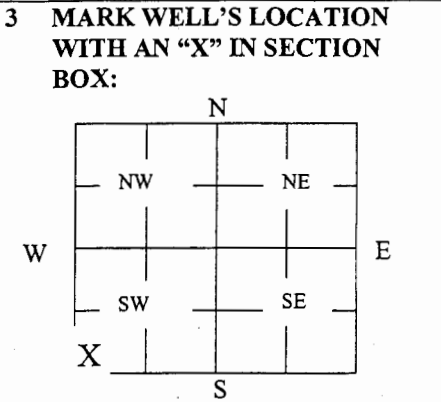

4 DEPTH OF WELL 16.03 ft.
WELL'S STATIC WATER LEVEL 9.64 ft.
WELL WAS USED AS: X
1 Domestic 5 Public Water Supply 9 Dewatering
2 Irrigation 6 Oil Field Water Supply 10 Monitoring X
3 Feedlot 7 Domestic (Lawn & Garden) 11 Injection Well
4 Industrial 8 Air Conditioning 12 Other _____
Was a chemical/bacteriological sample submitted to Department? Yes ___ No x ___

5 TYPE OF BLANK CASING USED:
1 Steel 3 RMP (SR) 5 Wrought 7 Fiberglass 9 Other (Specify below)
 2 PVC 4 ABS 6 Asbestos-Cement 8 Concrete Tile _____
Blank casing diameter 2 in. Was casing pulled? Yes x No _____ If yes, how much 1'
Casing height above or below land surface 12 in.

6 GROUT PLUG MATERIAL: 1 Neat cement 2 Cement grout 3 Bentonite 4 Other ASPHALT
Grout Plug Intervals: From 0 ft. to 1 ft., From 1 ft. to 16.03 ft., From _____ to _____ ft.

What is the nearest source of possible contamination:
1 Septic tank 6 Seepage pit 11 Fuel Storage 16 Other (specify below)
2 Sewer lines 7 Pit privy 12 Fertilizer storage Contaminated Site
3 Watertight sewer lines 8 Sewage lagoon 13 Insecticide storage
4 Lateral lines 9 Feedyard 14 Abandoned water well Direction from well? _____
5 Cess pool 10 Livestock pens 15 Oil well/Gas well How many feet? _____

FROM	TO	PLUGGING MATERIALS	FROM	TO	PLUGGING MATERIALS
0'	1'	ASPHALT			
3'	16.81'	Bentonite Chips			

7 CONTRACTOR'S OR LANDOWNER'S CERTIFICATION: This water well was plugged under my jurisdiction and was completed on (mo/day/year) 7/25/16 and this record is true to the best of my knowledge and belief. Kansas Water Well Contractor's License No. 585. This Water Well Record was completed on (mo/day/year) 8/3/16 under the business name of Associated Environmental, Inc. by (signature) *[Signature]*

INSTRUCTIONS: Use typewriter or ballpoint pen. Please press firmly and print clearly. Please fill in blanks, underline or circle the correct answers. Send top three copies to Kansas Department of Health and Environment, Bureau of Water, Geology Section, 1000 SW Jackson St., Ste. 420, Topeka, Kansas 66612-1367. Telephone: 785/296-5522. Send one to Water Well Owner and retain one for your records. Visit us at <http://www.kdheks.gov/waterwell/index.html>.