

WATER WELL RECORD Form WWC-5


Original Record Correction Change in Well Use

Division of Water Resources App. No.

Well ID MW-2

1 LOCATION OF WATER WELL: County: Shawnee Fraction ¼ SE ¼ SE ¼ SE ¼ Section Number 8 Township Number T 12 S Range Number R 15 E W

2 WELL OWNER: Last Name: First: Kansasland Tire - Gas For Less Street or Rural Address where well is located (if unknown, distance and direction from nearest town or intersection): If at owner's address, check here:
 Address: 2855 SW Wanamaker Road 2855 SW Wanamaker Road
 Address: 2855 SW Wanamaker Road
 City: Topeka State: KS ZIP: 66614 Topeka, KS 66614

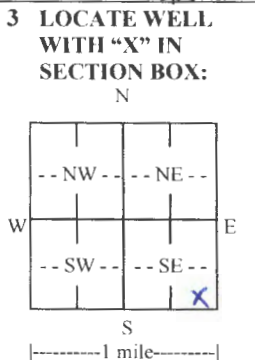

4 DEPTH OF COMPLETED WELL: 23 ft.
 Depth(s) Groundwater Encountered: 1) 6.37 ft.
 2) N/A ft. 3) N/A ft., or 4) Dry Well
 WELL'S STATIC WATER LEVEL: 6-6-2018 ft.
 below land surface, measured on (mo-day-yr)
 above land surface, measured on (mo-day-yr)
 Pump test data: Well water was N/A ft.
 after N/A hours pumping N/A gpm
 Well water was N/A ft.
 after N/A hours pumping N/A gpm
 Estimated Yield: N/A gpm
 Bore Hole Diameter: 8.25 in. to 23 ft. and
N/A in. to N/A ft.

5 Latitude: 39.016064 (decimal degrees)
Longitude: -95.762728 (decimal degrees)
Horizontal Datum: WGS 84 NAD 83 NAD 27
Source for Latitude/Longitude:
 GPS (unit make/model: _____)
 (WAAS enabled? Yes No)
 Land Survey Topographic Map
 Online Mapper: _____

6 Elevation: 990 ft. Ground Level TOC
Source: Land Survey GPS Topographic Map
 Other _____

7 WELL WATER TO BE USED AS:

1. Domestic: <input type="checkbox"/> Household <input type="checkbox"/> Lawn & Garden <input type="checkbox"/> Livestock	5. <input type="checkbox"/> Public Water Supply: well ID _____ 6. <input type="checkbox"/> Dewatering: how many wells? _____ 7. <input type="checkbox"/> Aquifer Recharge: well ID _____ 8. <input checked="" type="checkbox"/> Monitoring: well ID <u>MW-2</u>	10. <input type="checkbox"/> Oil Field Water Supply: lease _____ 11. Test Hole: well ID _____ <input type="checkbox"/> Cased <input type="checkbox"/> Uncased <input type="checkbox"/> Geotechnical 12. Geothermal: how many bores? _____ a) Closed Loop <input type="checkbox"/> Horizontal <input type="checkbox"/> Vertical b) Open Loop <input type="checkbox"/> Surface Discharge <input type="checkbox"/> Inj. of Water
2. <input type="checkbox"/> Irrigation 3. <input type="checkbox"/> Feedlot 4. <input type="checkbox"/> Industrial	9. Environmental Remediation: well ID _____ <input type="checkbox"/> Air Sparge <input type="checkbox"/> Soil Vapor Extraction <input type="checkbox"/> Recovery <input type="checkbox"/> Injection	13. <input type="checkbox"/> Other (specify): _____

Was a chemical/bacteriological sample submitted to KDHE? Yes No If yes, date sample was submitted: _____
 Water well disinfected? Yes No

8 TYPE OF CASING USED: Steel PVC Other _____ CASING JOINTS: Glued Clamped Welded Threaded
 Casing diameter 2 in. to 13 ft., Diameter N/A in. to N/A ft., Diameter N/A in. to N/A ft.
 Casing height above land surface 0 in. Weight N/A lbs./ft. Wall thickness or gauge No. Sch. 40

TYPE OF SCREEN OR PERFORATION MATERIAL:
 Steel Stainless Steel Fiberglass PVC Other (Specify) _____
 Brass Galvanized Steel Concrete tile None used (open hole)

SCREEN OR PERFORATION OPENINGS ARE:
 Continuous Slot Mill Slot Gauze Wrapped Torch Cut Drilled Holes Other (Specify) _____
 Louvered Shutter Key Punched Wire Wrapped Saw Cut None (Open Hole)

SCREEN-PERFORATED INTERVALS: From 13 ft. to 23 ft., From N/A ft. to N/A ft., From N/A ft. to N/A ft.
GRAVEL PACK INTERVALS: From 11 ft. to 23 ft., From N/A ft. to N/A ft., From N/A ft. to N/A ft.

9 GROUT MATERIAL: Neat cement Cement grout Bentonite Other Concrete 0 to 2
 Grout Intervals: From 2 ft. to 11 ft., From N/A ft. to N/A ft., From N/A ft. to N/A ft.

Nearest source of possible contamination:
 Septic Tank Lateral Lines Pit Privy Livestock Pens Insecticide Storage
 Sewer Lines Cess Pool Sewage Lagoon Fuel Storage Abandoned Water Well
 Watertight Sewer Lines Seepage Pit Feedyard Fertilizer Storage Oil Well/Gas Well
 Other (Specify) _____
 Direction from well? East Distance from well? 115 ft.

10 FROM	TO	LITHOLOGIC LOG	FROM	TO	LITHO. LOG (cont.) or PLUGGING INTERVALS
0	0.5	Concrete			
0.5	8	Clay (CH) dark gray/black moist			
8	9	Clay (CH) gray brown, moist			
9	15	Clay (CH) brown, moisture increasing			
15	23	No Recovery			
23		Sandstone (Refusal)			

Notes:

11 CONTRACTOR'S OR LANDOWNER'S CERTIFICATION: This water well was constructed, reconstructed, or plugged under my jurisdiction and was completed on (mo-day-year) 6-6-2018 and this record is true to the best of my knowledge and belief. Kansas Water Well Contractor's License No. 759 This Water Well Record was completed on (mo-day year) 7-8-2018 under the business name of RAZEK Environmental, LLC Signature: [Signature]

Mail 1 white copy along with a fee of \$5.00 for each constructed well to: Kansas Department of Health and Environment, Bureau of Water, GWTS Section, 1000 SW Jackson St., Suite 420, Topeka, Kansas 66612-1367. Mail one to Water Well Owner and retain one for your records. Telephone 785-296-5524.
 Visit us at <http://www.kdheks.gov/waterwell/index.html> KSA 82a-1212 Revised 7/10/2015




Legend

- ⊙ Proposed Soil Boring for Petroleum Analysis
- ⊕ Proposed Soil Boring for Geotechnical Testing
- ⊕ Proposed Monitoring Well
- Former UST Basin and Pump Island
- Approximate Shawnee County Parcels
- Approximate Site Boundary
- Fiber/Communication
- Gas Line
- Overhead/Electric
- Sewer Line
- Estimated Direction of Groundwater Flow

Business Name

Property Owner

Some Offsite utilities are unknown at this time

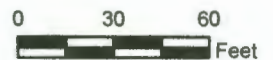

1 inch = 60 feet



11001 Hampshire Avenue S
 Minneapolis, MN 55438
 952.995.2000
 braunintertec.com

Project No:
 B1709587.02

Drawing No:
 B1709587-02_Fig2.0

Drawn By: CMF
 Date Drawn: 3/5/2018
 Checked By: DR
 Last Modified: 4/2/2018

Kansasland Tire -- Gas For Less

KDHE Project Code # U4-089-15027

2855 SW Wanamaker Road

Topeka, Kansas

Site Map

Figure 2.0