

**WATER WELL RECORD Form WWC-5**


Original Record  Correction  Change in Well Use

Division of Water Resources App. No.

Well ID MW-4

<b>1 LOCATION OF WATER WELL:</b> County: <b>Shawnee</b>	Fraction ¼ SE ¼ SE ¼ SE ¼	Section Number <b>8</b>	Township Number T <b>12</b> S	Range Number R <b>15</b> <input checked="" type="checkbox"/> E <input type="checkbox"/> W
--	------------------------------	----------------------------	----------------------------------	--

<b>2 WELL OWNER:</b> Last Name: <b>Kansasland Tire - Gas For Less</b> First: _____ Business: <b>2855 SW Wanamaker Road</b> Address: <b>2855 SW Wanamaker Road</b> City: <b>Topeka</b> State: <b>KS</b> ZIP: <b>66614</b>	Street or Rural Address where well is located (if unknown, distance and direction from nearest town or intersection): If at owner's address, check here: <input checked="" type="checkbox"/> <b>2855 SW Wanamaker Road</b> <b>Topeka, KS 66614</b>
---	--

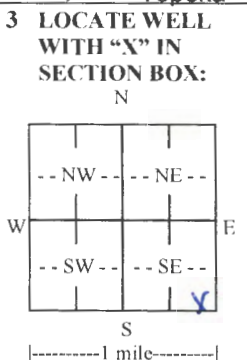

**4 DEPTH OF COMPLETED WELL:** 23.5 ft.

Depth(s) Groundwater Encountered: 1) 8.92 ft.  
 2) N/A ft. 3) N/A ft., or 4)  Dry Well

WELL'S STATIC WATER LEVEL: \_\_\_\_\_ ft.

below land surface, measured on (mo-day-yr) 6-6-2018  
 above land surface, measured on (mo-day-yr) \_\_\_\_\_

Pump test data: Well water was N/A ft.  
 after N/A hours pumping N/A gpm  
 Well water was N/A ft.  
 after N/A hours pumping N/A gpm

Estimated Yield: N/A gpm

Bore Hole Diameter: 8.25 in. to 23.5 ft. and  
 N/A in. to N/A ft.

**5 Latitude:** 39.015872 (decimal degrees)  
**Longitude:** -95.762889 (decimal degrees)  
 Horizontal Datum:  WGS 84  NAD 83  NAD 27  
 Source for Latitude/Longitude:  
 GPS (unit make/model: \_\_\_\_\_)  
 (WAAS enabled?  Yes  No)  
 Land Survey  Topographic Map  
 Online Mapper: \_\_\_\_\_

**6 Elevation:** 992 ft.  Ground Level  TOC  
 Source:  Land Survey  GPS  Topographic Map  
 Other \_\_\_\_\_

**7 WELL WATER TO BE USED AS:**

1. Domestic: <input type="checkbox"/> Household <input type="checkbox"/> Lawn & Garden <input type="checkbox"/> Livestock 2. <input type="checkbox"/> Irrigation 3. <input type="checkbox"/> Feedlot 4. <input type="checkbox"/> Industrial	5. <input type="checkbox"/> Public Water Supply: well ID _____ 6. <input type="checkbox"/> Dewatering: how many wells? _____ 7. <input type="checkbox"/> Aquifer Recharge: well ID _____ 8. <input checked="" type="checkbox"/> Monitoring: well ID <b>MW-4</b> 9. Environmental Remediation: well ID _____ <input type="checkbox"/> Air Sparge <input type="checkbox"/> Soil Vapor Extraction <input type="checkbox"/> Recovery <input type="checkbox"/> Injection	10. <input type="checkbox"/> Oil Field Water Supply: lease _____ 11. Test Hole: well ID _____ <input type="checkbox"/> Cased <input type="checkbox"/> Uncased <input type="checkbox"/> Geotechnical 12. Geothermal: how many bores? _____ a) Closed Loop <input type="checkbox"/> Horizontal <input type="checkbox"/> Vertical b) Open Loop <input type="checkbox"/> Surface Discharge <input type="checkbox"/> Inj. of Water 13. <input type="checkbox"/> Other (specify): _____
---	---	---

Was a chemical/bacteriological sample submitted to KDHE?  Yes  No If yes, date sample was submitted: \_\_\_\_\_  
 Water well disinfected?  Yes  No

**8 TYPE OF CASING USED:**  Steel  PVC  Other \_\_\_\_\_ CASING JOINTS:  Glued  Clamped  Welded  Threaded  
 Casing diameter 2 in. to 13.5 ft., Diameter N/A in. to N/A ft., Diameter N/A in. to N/A ft.  
 Casing height above land surface 0 in. Weight N/A lbs./ft. Wall thickness or gauge No. Sch. 40

TYPE OF SCREEN OR PERFORATION MATERIAL:  
 Steel  Stainless Steel  Fiberglass  PVC  Other (Specify) \_\_\_\_\_  
 Brass  Galvanized Steel  Concrete tile  None used (open hole)

SCREEN OR PERFORATION OPENINGS ARE:  
 Continuous Slot  Mill Slot  Gauze Wrapped  Torch Cut  Drilled Holes  Other (Specify) \_\_\_\_\_  
 Louvered Shutter  Key Punched  Wire Wrapped  Saw Cut  None (Open Hole)

SCREEN-PERFORATED INTERVALS: From 13.5 ft. to 23.5 ft., From N/A ft. to N/A ft., From N/A ft. to N/A ft.  
 GRAVEL PACK INTERVALS: From 11.5 ft. to 23.5 ft., From N/A ft. to N/A ft., From N/A ft. to N/A ft.

**9 GROUT MATERIAL:**  Neat cement  Cement grout  Bentonite  Other **Concrete 0 to 2**  
 Grout Intervals: From 2 ft. to 11.5 ft., From N/A ft. to N/A ft., From N/A ft. to N/A ft.

**Nearest source of possible contamination:**  
 Septic Tank  Lateral Lines  Pit Privy  Livestock Pens  Insecticide Storage  
 Sewer Lines  Cess Pool  Sewage Lagoon  Fuel Storage  Abandoned Water Well  
 Watertight Sewer Lines  Seepage Pit  Feedyard  Fertilizer Storage  Oil Well/Gas Well  
 Other (Specify) \_\_\_\_\_  
 Direction from well? **Northwest** Distance from well? **70** ft.

10 FROM	TO	LITHOLOGIC LOG	FROM	TO	LITHO. LOG (cont.) or PLUGGING INTERVALS
0	0.5	Concrete			
0.5	8	Clay(CH) dark gray/black moist, faint odor			
8	14	Clay(CH) olive gray, moist			
14	20	AA with faint petro odor			
20	23.5	Clay(CH) olive gray, moisture increasing			
23.5		Sandstone (Refusal)			
Notes:					

**11 CONTRACTOR'S OR LANDOWNER'S CERTIFICATION:** This water well was  constructed,  reconstructed, or  plugged under my jurisdiction and was completed on (mo-day-year) **6-5-2018** and this record is true to the best of my knowledge and belief. Kansas Water Well Contractor's License No. **759**. This Water Well Record was completed on (mo-day-year) **7-8-2018** under the business name of **RAZEK Environmental, LLC** Signature *[Signature]*


Mail 1 white copy along with a fee of \$5.00 for each constructed well to: Kansas Department of Health and Environment, Bureau of Water, GWTS Section, 1000 SW Jackson St., Suite 420, Topeka, Kansas 66612-1367. Mail one to Water Well Owner and retain one for your records. Telephone 785-296-5524.



**Legend**

- ⊙ Proposed Soil Boring for Petroleum Analysis
- ⊕ Proposed Soil Boring for Geotechnical Testing
- ⊕ Proposed Monitoring Well
- Former UST Basin and Pump Island
- Approximate Shawnee County Parcels
- Approximate Site Boundary
- Fiber/Communication
- Gas Line
- ⊕ Overhead/Electric
- S Sewer Line
- ➔ Estimated Direction of Groundwater Flow

**Business Name**  
**Property Owner**  
 Some Offsite utilities are unknown at this time

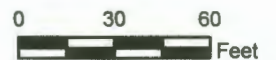

1 inch = 60 feet



11001 Hampshire Avenue S  
 Minneapolis, MN 55438  
 952.995.2000  
 braunintertec.com

Project No:  
 B1709587.02

Drawing No:  
 B1709587-02\_Fig2.0

Drawn By: CMF  
 Date Drawn: 3/5/2018  
 Checked By: DR  
 Last Modified: 4/2/2018

Kansasland Tire – Gas For Less

KDHE Project Code # U4-089-15027

2855 SW Wanamaker Road

Topeka, Kansas

**Site Map**

Figure 2.0