

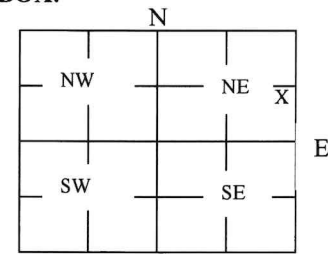
WATER WELL PLUGGING RECORD Form WWC-5P KSA 82a-1212 ID NO.

NMW14

| | | | | |
|--|--|-----------------------------|----------------------------------|--|
| 1 LOCATION OF WATER WELL: County: Shawnee | Fraction NW ¼ NE ¼ SE ¼ NE ¼ | Section Number 36 | Township Number T 12 S | Range Number R 15 <input checked="" type="checkbox"/> E <input type="checkbox"/> W |
|--|--|-----------------------------|----------------------------------|--|

| | |
|--|--|
| Street/Rural Address of Well Location; if unknown, distance & direction from nearest town or intersection: If at owner's address, check here <input type="checkbox"/> 416 SW 57th Street, Topeka, KS | Global Positioning Systems (GPS) information: Latitude: <u>N 38.96750</u> (in decimal degrees) Longitude: <u>W 95.68901</u> (in decimal degrees) Elevation: <u>TOC: 1019.48</u> Horizontal Datum: <input checked="" type="checkbox"/> WGS84, <input type="checkbox"/> NAD83, <input type="checkbox"/> NAD27 Collection Method: |
|--|--|

| | |
|--|---|
| 2 WATER WELL OWNER: Lindemuth, Inc. (Pauline Farm RR#, St. Address, Box #: 125 SW Gage Blvd City, State ZIP Code: Topeka, KS 66606-2029 | <input type="checkbox"/> GPS unit (Make/Model: _____ <input type="checkbox"/> Digital Map/Photo, <input type="checkbox"/> Topographic Map, <input checked="" type="checkbox"/> Land Survey Est. Accuracy: <input checked="" type="checkbox"/> < 3 m, <input type="checkbox"/> 3-5 m, <input type="checkbox"/> 5-15 m, <input type="checkbox"/> > 15 m |
|--|---|

| | |
|--|--|
| 3 MARK WELL'S LOCATION WITH AN "X" IN SECTION BOX:  | 4 DEPTH OF WELL <u>8.65</u> ft. WELL'S STATIC WATER LEVEL <u>2.95</u> ft. WELL WAS USED AS: <input type="checkbox"/> Domestic <input type="checkbox"/> Public Water Supply <input type="checkbox"/> Dewatering <input type="checkbox"/> Irrigation <input type="checkbox"/> Oil Field Water Supply <input checked="" type="checkbox"/> Monitoring <input type="checkbox"/> Feedlot <input type="checkbox"/> Domestic (Lawn & Garden) <input type="checkbox"/> Injection Well <input type="checkbox"/> Industrial <input type="checkbox"/> Air Conditioning <input type="checkbox"/> Other _____ Was a chemical/bacteriological sample submitted to Department? Yes <input type="checkbox"/> No <input checked="" type="checkbox"/> |
|--|--|

5 TYPE OF BLANK CASING USED:

Steel RMP (SR) Wrought Fiberglass Other (Specify below) _____
 PVC ABS Asbestos-Cement Concrete Tile

Blank casing diameter 2 in. Was casing pulled? Yes No If yes, how much 8.65 ft
 Casing height above or below land surface -46 ft in.

6 GROUT PLUG MATERIAL: Neat cement Cement grout Bentonite Other _____

Grout Plug Intervals: From 8.65 ft. to 0 ft., From _____ ft. to _____ ft., From _____ ft. to _____ ft.

What is the nearest source of possible contamination:

| | | | |
|---|---|--|--|
| <input type="checkbox"/> Septic tank | <input type="checkbox"/> Seepage pit | <input checked="" type="checkbox"/> Fuel storage | <input type="checkbox"/> Other (specify below) _____ |
| <input type="checkbox"/> Sewer lines | <input type="checkbox"/> Pit privy | <input checked="" type="checkbox"/> Fertilizer storage | |
| <input type="checkbox"/> Watertight sewer lines | <input type="checkbox"/> Sewage lagoon | <input type="checkbox"/> Insecticide storage | |
| <input type="checkbox"/> Lateral lines | <input type="checkbox"/> Feedyard | <input type="checkbox"/> Abandoned water well | Direction from well? _____ |
| <input type="checkbox"/> Cess pool | <input type="checkbox"/> Livestock pens | <input type="checkbox"/> Oil well/Gas well | How many feet? _____ |

| FROM | TO | PLUGGING MATERIALS | FROM | TO | PLUGGING MATERIALS |
|------|------|--------------------|------|----|--------------------|
| 0 | .5 | Topsoil/Grass Seed | | | |
| .5 | 8.65 | Neat Cement | | | |
| | | | | | |
| | | | | | |
| | | | | | |
| | | | | | |

7 CONTRACTOR'S OR LANDOWNER'S CERTIFICATION: This water well was plugged under my jurisdiction and was completed on (mo/day/year) 4/24/2023 and this record is true to the best of my knowledge and belief. Kansas Water Well Contractor's License No. PG294. This Water Well Record was completed on (mo/day/year) 6/7/2023 under the business name of ppB enviro-solutions by (signature) [Signature]