


1 LOCATION OF WATER WELL: Fraction SW 1/4 SW 1/4 SW 1/4 Section Number 10 Township Number T 12 S Range Number R 15 EW  
 County: SHAWNEE

Distance and direction from nearest town or city street address of well if located within city?  
NE COR. OF INTER. OF 29TH ST AND FAIRLAWN, TOPEKA

2 WATER WELL OWNER: THOMAS BINKLEY  
 RR#, St. Address, Box #: 2219 SW TERRACE #24 Board of Agriculture, Division of Water Resources  
 City, State, ZIP Code: TOPEKA KS 66611 Application Number:

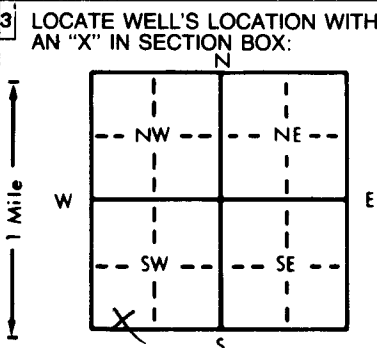

4 DEPTH OF COMPLETED WELL: 20.5 ft. ELEVATION: 945.61  
 Depth(s) Groundwater Encountered 1. 13.8 ft. 2. — ft. 3. — ft.  
 WELL'S STATIC WATER LEVEL 9.95 ft. below land surface measured on mo/day/yr 07.06.92  
 Pump test data: Well water was — ft. after — hours pumping — gpm  
 Est. Yield .23 gpm: Well water was — ft. after — hours pumping — gpm  
 Bore Hole Diameter 11 in. to 20 ft., and 2 in. to 22 ft.  
 WELL WATER TO BE USED AS:  
 5 Public water supply 8 Air conditioning 11 Injection well  
 1 Domestic 3 Feedlot 6 Oil field water supply 9 Dewatering 12 Other (Specify below)  
 2 Irrigation 4 Industrial 7 Lawn and garden only 10 Monitoring well  
 Was a chemical/bacteriological sample submitted to Department? Yes — No X; If yes, mo/day/yr sample was submitted —  
 Water Well Disinfected? Yes — No X

5 TYPE OF BLANK CASING USED:  
 1 Steel 3 RMP (SR) 5 Wrought iron 8 Concrete tile CASING JOINTS: Glued — Clamped —  
 2 PVC 4 ABS 6 Asbestos-Cement 9 Other (specify below) Welded —  
 7 Fiberglass Threaded X  
 Blank casing diameter 2 in. to 20.5 ft., Dia — in. to — ft., Dia — in. to — ft.  
 Casing height above land surface .5 in., weight 36 lb lbs./ft. Wall thickness or gauge No. —  
 TYPE OF SCREEN OR PERFORATION MATERIAL:  
 1 Steel 3 Stainless steel 5 Fiberglass 7 PVC 10 Asbestos-cement  
 2 Brass 4 Galvanized steel 6 Concrete tile 8 RMP (SR) 11 Other (specify) —  
 9 ABS 12 None used (open hole)  
 SCREEN OR PERFORATION OPENINGS ARE:  
 1 Continuous slot 3 Mill slot 5 Gauzed wrapped 8 Saw cut 11 None (open hole)  
 2 Louvered shutter 4 Key punched 6 Wire wrapped 9 Drilled holes  
 7 Torch cut 10 Other (specify) —  
 SCREEN-PERFORATED INTERVALS: From 10.5 ft. to 20.5 ft., From — ft. to — ft.  
 From — ft. to — ft., From — ft. to — ft.  
 GRAVEL PACK INTERVALS: From 9.5 ft. to 20.5 ft., From — ft. to — ft.  
 From — ft. to — ft., From — ft. to — ft.

6 GROUT MATERIAL: 1 Neat cement 2 Cement grout 3 Bentonite 4 Other —  
 Grout Intervals: From 6.5 ft. to 9.5 ft., From — ft. to — ft., From — ft. to — ft.  
 What is the nearest source of possible contamination:  
 1 Septic tank 4 Lateral lines 7 Pit privy 10 Livestock pens 14 Abandoned water well  
 2 Sewer lines 5 Cess pool 8 Sewage lagoon 11 Fuel storage 15 Oil well/Gas well  
 3 Watertight sewer lines 6 Seepage pit 9 Feedyard 12 Fertilizer storage 16 Other (specify below)  
 13 Insecticide storage CONTAMINATED  
 Direction from well? — How many feet? —

FROM	TO	LITHOLOGIC LOG	FROM	TO	PLUGGING INTERVALS
<u>0</u>	<u>5</u>	<u>CONCRETE</u>			
<u>.5</u>	<u>2.0</u>	<u>FILL</u>			
<u>2.0</u>	<u>5.2</u>	<u>SILTY CLAY DK GRY.</u>			
<u>5.2</u>	<u>8.0</u>	<u>SILTY CLAY GRY - SCT GRAVEL</u>			
<u>8.0</u>	<u>10.2</u>	<u>SILTY CLAY GRY - STRONG ODOUR GAS</u>			
<u>10.2</u>	<u>15.5</u>	<u>SILTY CLAY GRY - BR. STAINS</u>			
<u>15.5</u>	<u>22.0</u>	<u>SILTY CLAY GRY - TIGHT</u>			

7 CONTRACTOR'S OR LANDOWNER'S CERTIFICATION: This water well was (1) constructed, (2) reconstructed, or (3) plugged under my jurisdiction and was completed on (mo/day/year) 06-30-92 and this record is true to the best of my knowledge and belief. Kansas Water Well Contractor's License No. 479 This Water Well Record was completed on (mo/day/yr) 07-26-92 under the business name of EBBERTS DRILLING by (signature) Gregory Ebberts

OFFICE USE ONLY  
T  
R  
EW  
SEC.  
1/4  
1/4  
1/4