

OFFICE USE ONLY

T

R

EW

SEC.

1/4

1/4


1/4

1/4

1 LOCATION OF WATER WELL: Fraction **NE** 1/4 **NW** 1/4 **NE** 1/4 Section Number **12** Township Number **T 12 S** Range Number **R 15** **EW**
 County: **Shawnee**

Distance and direction from nearest town or city street address of well if located within city?
1201 W 21st Street, Topeka, Kansas

2 WATER WELL OWNER: **Amoco Oil Company**
 RR#, St. Address, Box # : **8700 Indian Creek Parkway** Board of Agriculture, Division of Water Resources
 City, State, ZIP Code : **Overland Park, Kansas 66210** Application Number:

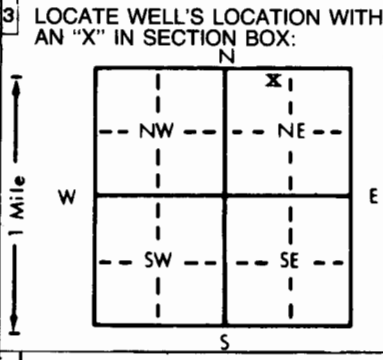

4 DEPTH OF COMPLETED WELL: **6.0** ft. ELEVATION:
 Depth(s) Groundwater Encountered 1. **Dry** ft. 2. ft. 3. ft.
 WELL'S STATIC WATER LEVEL **5.29** ft. below land surface measured on mo/day/yr **9/25/89**
 Pump test data: Well water was ft. after hours pumping gpm
 Est. Yield gpm: Well water was ft. after hours pumping gpm
 Bore Hole Diameter **6** in. to **6.0** ft., and in. to ft.
 WELL WATER TO BE USED AS: 5 Public water supply 8 Air conditioning 11 Injection well
 1 Domestic 3 Feedlot 6 Oil field water supply 9 Dewatering 12 Other (Specify below)
 2 Irrigation 4 Industrial 7 Lawn and garden only 10 Monitoring well
 Was a chemical/bacteriological sample submitted to Department? Yes No **X**; If yes, mo/day/yr sample was submitted
 Water Well Disinfected? Yes No **X**

5 TYPE OF BLANK CASING USED: 5 Wrought iron 8 Concrete tile CASING JOINTS: Glued Clamped
 1 Steel 3 RMP (SR) 6 Asbestos-Cement 9 Other (specify below) Welded
 2 PVC 4 ABS 7 Fiberglass Threaded **X**
 Blank casing diameter **2** in. to **3.5** ft., Dia in. to ft., Dia in. to ft.
 Casing height above land surface **-0.18'** in., weight lbs./ft. Wall thickness or gauge No. **SCH. 40**
 TYPE OF SCREEN OR PERFORATION MATERIAL: 7 PVC 10 Asbestos-cement
 1 Steel 3 Stainless steel 5 Fiberglass 8 RMP (SR) 11 Other (specify)
 2 Brass 4 Galvanized steel 6 Concrete tile 9 ABS 12 None used (open hole)
 SCREEN OR PERFORATION OPENINGS ARE: 5 Gauzed wrapped 8 Saw cut 11 None (open hole)
 1 Continuous slot 3 Mill slot 6 Wire wrapped 9 Drilled holes
 2 Louvered shutter 4 Key punched 7 Torch cut 10 Other (specify)
 SCREEN-PERFORATED INTERVALS: From **3.5** ft. to **6.0** ft., From ft. to ft.
 From ft. to ft., From ft. to ft.
 GRAVEL PACK INTERVALS: From **2.5** ft. to **6.0** ft., From ft. to ft.
 From ft. to ft., From ft. to ft.

6 GROUT MATERIAL: 1 Neat cement 2 Cement grout 3 Bentonite 4 Other
 Grout Intervals: From ft. to ft., From ft. to ft., From ft. to ft.
 What is the nearest source of possible contamination:
 1 Septic tank 4 Lateral lines 7 Pit privy 10 Livestock pens 14 Abandoned water well
 2 Sewer lines 5 Cess pool 8 Sewage lagoon 11 Fuel storage 15 Oil well/Gas well
 3 Watertight sewer lines 6 Seepage pit 9 Feedyard 12 Fertilizer storage 16 Other (specify below)
 13 Insecticide storage
 Direction from well? **South** How many feet? **15**

FROM	TO	LITHOLOGIC LOG	FROM	TO	PLUGGING INTERVALS
0.0	0.4	Concrete	5.8	6.0	Limestone
0.4	1.0	Lean Clay Gray Brown			
1.0	2.8	Lean to Fat Clay - Mottled Reddish Brown and Black with Sand and Pebbles			
2.8	4.0	Lean to Fat Clay - Mottled Reddish Brown and Yellow with Pebbles and Silt Seams			
4.0	5.8	Highly Weathered Limestone with Clay Seams			

7 CONTRACTOR'S OR LANDOWNER'S CERTIFICATION: This water well was (1) constructed, (2) reconstructed, or (3) plugged under my jurisdiction and was completed on (mo/day/year) **9/20/89** and this record is true to the best of my knowledge and belief. Kansas Water Well Contractor's License No. **416** This Water Well Record was completed on (mo/day/yr) **9/29/89** under the business name of **Terracon Consultants** by (signature) *W.D. Semley*