


1 LOCATION OF WATER WELL: Fraction NW 1/4 NE 1/4 NE 1/4 Section Number 14 Township Number T 12 S Range Number R 15 E

County: Shawnee Distance and direction from nearest town or city street address of well if located within city? 2525 SW 27th Street, Topeka KS (NW corner of C-Mart convenience store property)

2 WATER WELL OWNER: Coastal Mart, Inc (Facility #9121) KDHE Site ID #00002266 Board of Agriculture, Division of Water Resources Application Number: N/A

3 LOCATE WELL'S LOCATION WITH AN "X" IN SECTION BOX:

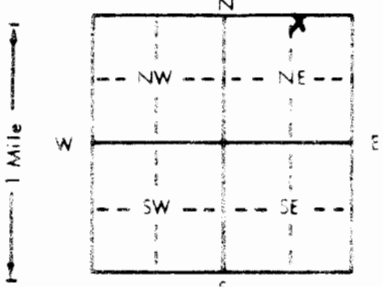

4 DEPTH OF COMPLETED WELL: 18' ft. ELEVATION: Not encountered

Depth(s) Groundwater Encountered: Not encountered
 WELL'S STATIC WATER LEVEL: 10.5 ft. below land surface measured on mo/day/yr 11-6-92
 Pump test data: Well water was ... ft. after ... hours pumping ... gpm
 Est. Yield ... gpm. Well water was ... ft. after ... hours pumping ... gpm
 Bore Hole Diameter: 6 in. to 18 in. and ... in. to ... in.
 WELL WATER TO BE USED AS:
 1 Domestic 2 Irrigation 3 Feedlot 4 Industrial 5 Oil field water supply 6 Public water supply 7 Lawn and garden only 8 Air conditioning 9 Dewatering 10 Monitoring well (gasoline release site) 11 Injection well 12 Other (Specify below)
 Was a chemical/bacteriological sample submitted to Department? Yes No X If yes, mo/day/yr sample was submitted Water Well Disinfected? Yes No X

5 TYPE OF BLANK CASING USED: 1 Steel 2 Brass 3 RMP (SR) 4 ABS 5 Wrought iron 6 Asbestos-Cement 7 Fiberglass 8 Concrete tile 9 Other (specify below) CASING JOINTS: Glued Clamped Welded Threaded

Blank casing diameter: 2" in. to 18" ft. Dia. Casing height above land surface: 0 in. weight lbs./ft. Wall thickness or gauge No. Sch 40

TYPE OF SCREEN OR PERFORATION MATERIAL: 1 Steel 2 Brass 3 Stainless steel 4 Galvanized steel 5 Fiberglass 6 Concrete tile 7 PVC 8 RMP (SR) 9 ABS 10 Asbestos-cement 11 Other (specify) 12 None used (open hole)

SCREEN OR PERFORATION OPENINGS ARE: 1 Continuous slot 2 Louvered shutter 3 Mill slot 4 Key punched 5 Gauzed wrapped 6 Wire wrapped 7 Torch cut 8 Saw cut 9 Drilled holes 10 Other (specify) 11 None (open hole)

SCREEN-PERFORATED INTERVALS: From 8 ft. to 18 ft. GRAVEL PACK INTERVALS: From 5 ft. to 18 ft.

6 GROUT MATERIAL: 1 Neat cement 2 Cement grout 3 Bentonite 4 Other Grout intervals: From 0 ft. to 5 ft. From 10 ft. to ... ft.

What is the nearest source of possible contamination: 1 Septic tank 2 Sewer lines 3 Watertight sewer lines 4 Lateral lines 5 Cess pool 6 Seepage pit 7 Pit privy 8 Sewage lagoon 9 Feedyard 10 Livestock pens 11 Fuel storage 12 Fertilizer storage 13 Insecticide storage 14 Abandoned water well 15 Oil well/Gas well 16 Other (specify below) Service Station (petroleum storage)

Direction from well? (2) - 10' N (1) - 280' SE How many feet?

FROM	TO	LITHOLOGIC LOG	FROM	TO	PLUGGING INTERVALS
0'	5'	Brown silty clay, soft			
5'	8'	Dark grey clay, soft, slightly silty			
8'	13'	Grey to black (stain?) slight petroleum odor. clay silty			
13'	18'				
18.5'	AR	Shaley Limestone, gray			

Note - gw eventually came into well but not during drilling. Strong petroleum odor in borehole on 11-6-92. Water sample collected 11-13-92. AR = Auger Refusal

7 CONTRACTOR'S OR LANDOWNER'S CERTIFICATION: This water well was (1) constructed, (2) reconstructed, or (3) plugged under my jurisdiction and was completed on (mo/day/year) 10-28-92 and this record is true to the best of my knowledge and belief. Kansas Water Well Contractor's License No. John Gray This Water Well Record was completed on (mo/day/yr) 11-16-92 under the business name of KDHE - BER (Trust Fund Site) by (signature) Manuel Kellerman