


1 LOCATION OF WATER WELL: Fraction SW 1/4 SW 1/4 NW 1/4 Section Number 16 Township Number T 12 S Range Number R 15 E/W
 County: SHAWNEE

Distance and direction from nearest town or city street address of well if located within city?
 5915 SW 31st Terrace

2 WATER WELL OWNER: Dick Dennison
 RR#, St. Address, Box #: 5915 SW 31st Terrace Board of Agriculture, Division of Water Resources
 City, State, ZIP Code: Topeka, Kansas Application Number:

3 LOCATE WELL'S LOCATION WITH AN "X" IN SECTION BOX:

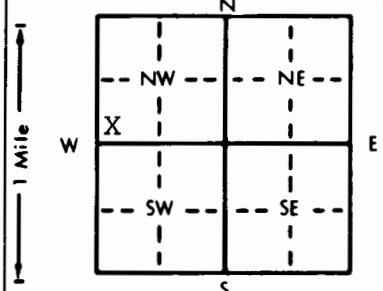

4 DEPTH OF COMPLETED WELL... 60 ft. ELEVATION:
 Depth(s) Groundwater Encountered 1... 15' ft. 2... ft. 3... ft.
 WELL'S STATIC WATER LEVEL... 10' ft. below land surface measured on mo/day/yr 4-15-92
 Pump test data: Well water was ... ft. after ... hours pumping ... gpm
 Est. Yield .8... gpm: Well water was ... ft. after ... hours pumping ... gpm
 Bore Hole Diameter .8. 3/4 .in. to ... ft., and ... in. to ... ft.
 WELL WATER TO BE USED AS:
 1 Domestic 3 Feedlot 6 Oil field water supply 9 Dewatering 12 Other (Specify below)
 2 Irrigation 4 Industrial 7 Lawn and garden only 10 Monitoring well
 Was a chemical/bacteriological sample submitted to Department? Yes.....No.....X...; If yes, mo/day/yr sample was submitted
 Water Well Disinfected? Yes X No

5 TYPE OF BLANK CASING USED:
 1 Steel 3 RMP (SR) 5 Wrought iron 8 Concrete tile CASING JOINTS: Glued Clamped
 2 PVC 4 ABS 6 Asbestos-Cement 9 Other (specify below) Welded
 7 Fiberglass Threaded.....

Blank casing diameter 5" .in. to ... 0-12 ft., Dia 5" .in. to ... 27-57 ft., Dia in. to ft.
 Casing height above land surface 24" .in., weight ... 2.82 lbs./ft. Wall thickness or gauge ~~188~~ ... 258

TYPE OF SCREEN OR PERFORATION MATERIAL:
 1 Steel 3 Stainless steel 5 Fiberglass 7 PVC 10 Asbestos-cement
 2 Brass 4 Galvanized steel 6 Concrete tile 8 RMP (SR) 11 Other (specify)
 12 None used (open hole)

SCREEN OR PERFORATION OPENINGS ARE:
 1 Continuous slot 3 Mill slot 5 Gauzed wrapped 8 Saw cut 11 None (open hole)
 2 Louvered shutter 4 Key punched 6 Wire wrapped 9 Drilled holes
 7 Torch cut 10 Other (specify)

SCREEN-PERFORATED INTERVALS: From 12 ft. to ... 27 ft., From ft. to ft.
 From 57 ft. to ... 60 ft., From ft. to ft.
 GRAVEL PACK INTERVALS: From 10 ft. to ... 60 ft., From ft. to ft.
 From ft. to ft., From ft. to ft.

6 GROUT MATERIAL: 1 Neat cement 2 Cement grout 3 Bentonite 4 Other
 Grout Intervals: From 0 ft. to ... 10 ft., From ft. to ft., From ft. to ft.

What is the nearest source of possible contamination:
 1 Septic tank 4 Lateral lines 7 Pit privy 10 Livestock pens 14 Abandoned water well
 2 Sewer lines 5 Cess pool 8 Sewage lagoon 11 Fuel storage 15 Oil well/Gas well
 3 Watertight sewer lines 6 Seepage pit 9 Feedyard 12 Fertilizer storage 16 Other (specify below)
 13 Insecticide storage creek.....

Direction from well? south How many feet? 35'

FROM	TO	LITHOLOGIC LOG	FROM	TO	PLUGGING INTERVALS
0	14	Clay-Brown			
14	15	Cherty Limestone-Yellow			NOTE: 4-22-92 Permission to shallow grout to 10' from Don Taylor
15	21	Clay-Blue			
21	23	Shale-Grey			
23	26	Limestone-Grey			
26	28	Shale-Grey			
28	30	Limestone-Grey			
30	52	Shale-Grey			
52	56	Sandstone-Grey			
56	60	Shale-Grey			

7 CONTRACTOR'S OR LANDOWNER'S CERTIFICATION: This water well was (1) constructed, (2) reconstructed, or (3) plugged under my jurisdiction and was completed on (mo/day/year) 4-15-92 and this record is true to the best of my knowledge and belief. Kansas Water Well Contractor's License No. 182. This Water Well Record was completed on (mo/day/yr) 5-6-92 under the business name of STRADER DRILLING CO., INC. by (signature) Dale Skren