


1 LOCATION OF WATER WELL: County: Shawnee Fraction: X N 1/2 NE 1/4 SW 1/4 Section Number: 17 Township Number: T 12 S Range Number: R 15 EW

Distance and direction from nearest town or city street address of well if located within city?
West of Topeka on Nottingham Road

2 WATER WELL OWNER: M. W. Watson, Inc.
 RR#, St. Address, Box # : 3333 East 21st Street Board of Agriculture, Division of Water Resources
 City, State, ZIP Code : Topeka, KS 66601 Application Number: 36000214

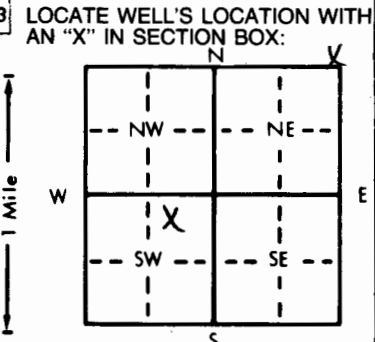

4 DEPTH OF COMPLETED WELL: 25' ft. ELEVATION:
 Depth(s) Groundwater Encountered 1. 13' ft. 2. ft. 3. ft.
 WELL'S STATIC WATER LEVEL 13' ft. below land surface measured on mo/day/yr X 9-10-82
 Pump test data: Well water was ft. after hours pumping gpm
 Est. Yield gpm: Well water was ft. after hours pumping gpm
 Bore Hole Diameter: X 3.0 in. to ft., and in. to ft.
 WELL WATER TO BE USED AS: 5 Public water supply 8 Air conditioning 11 Injection well
 1 Domestic 3 Feedlot 6 Oil field water supply 9 Dewatering 12 Other (Specify below)
 2 Irrigation 4 Industrial 7 Lawn and garden only 10 Observation well
 Was a chemical/bacteriological sample submitted to Department? Yes.....No X.....; If yes, mo/day/yr sample was submitted
 Water Well Disinfected? Yes No X

5 TYPE OF BLANK CASING USED: 5 Wrought iron 8 Concrete tile CASING JOINTS: Glued X Clamped
 1 Steel 3 RMP (SR) 6 Asbestos-Cement 9 Other (specify below) Welded
2 PVC 6 ABS 7 Fiberglass Threaded.....
 Blank casing diameter 8 in. to ft., Dia in. to ft., Dia in. to ft.
 Casing height above land surface X 2.4 in., weight lbs./ft. Wall thickness or gauge No X sch 40
 TYPE OF SCREEN OR PERFORATION MATERIAL: 7 PVC 10 Asbestos-cement
 1 Steel 3 Stainless steel 5 Fiberglass 8 RMP (SR) 11 Other (specify)
 2 Brass 4 Galvanized steel 6 Concrete tile 9 ABS 12 None used (open hole)
 SCREEN OR PERFORATION OPENINGS ARE: 5 Gauzed wrapped 8 Saw cut 11 None (open hole)
 1 Continuous slot 3 Mill slot 6 Wire wrapped 9 Drilled holes
 2 Louvered shutter 4 Key punched 7 Torch cut 10 Other (specify)
 SCREEN-PERFORATED INTERVALS: From X 13 ft. to 25 ft., From ft. to ft.
 From ft. to ft., From ft. to ft.
 GRAVEL PACK INTERVALS: From 13 ft. to TD ft., From ft. to ft.
 From ft. to ft., From ft. to ft.

6 GROUT MATERIAL: 1 Neat cement 2 Cement grout 3 Bentonite 4 Other NONE
 Grout intervals: From X ft. to ft., From ft. to ft., From ft. to ft.
 What is the nearest source of possible contamination: 10 Livestock pens 14 Abandoned water well
 1 Septic tank 4 Lateral lines 7 Pit privy 11 Fuel storage 15 Oil well/Gas well
2 Sewer lines 5 Cess pool 8 Sewage lagoon 12 Fertilizer storage 16 Other (specify below)
 3 Watertight sewer lines 6 Seepage pit 9 Feedyard 13 Insecticide storage
 Direction from well? X west How many feet? X 200

FROM	TO	LITHOLOGIC LOG	FROM	TO	LITHOLOGIC LOG
0'	5'	Hard brown clay			
5'	10'	Light brown & yellow clay hard			
10'	15'	Yellow clay Water 13'			
15'	20'	Yellow clay soft			
20'	22'	Dirty sand, gravel & bolders			
22'	25'	Shale			
25'		TD			

Grouting Variegated OK DP 1-26-83

7 CONTRACTOR'S OR LANDOWNER'S CERTIFICATION: This water well was (1) constructed, (2) reconstructed, or (3) plugged under my jurisdiction and was completed on (mo/day/year) Sept. 8, 9, 10, 1982 and this record is true to the best of my knowledge and belief. Kansas Water Well Contractor's License No. 435. This Water Well Record was completed on (mo/day/yr) Sept. 10, 1982 under the business name of John Brown & Company by (signature) John C. Brown

INSTRUCTIONS: Use typewriter or ball point pen, PLEASE PRESS FIRMLY and PRINT clearly. Please fill in blanks, underline or circle the correct answers. Send top three copies to Kansas Department of Health and Environment, Division of Environment, Environmental Geology Section, Topeka, KS 66620. Send one to WATER WELL OWNER and retain one for your records.

OFFICE USE ONLY
T
R
SEC. 17
1/4
1/4
1/4
1/4
1/4