


1 LOCATION OF WATER WELL: Fraction NE 1/4 SW 1/4 Section Number 17 Township Number T 12 S Range Number R 15 E/W  
 County: Shawnee

Distance and direction from nearest town or city street address of well if located within city?  
West of Topeka on Nottingham Road

2 WATER WELL OWNER: M. W. Watson, Inc. Board of Agriculture, Division of Water Resources  
 RR#, St. Address, Box # : 3333 East 21st Street Application Number: 36000212  
 City, State, ZIP Code : Topeka, KS 66601

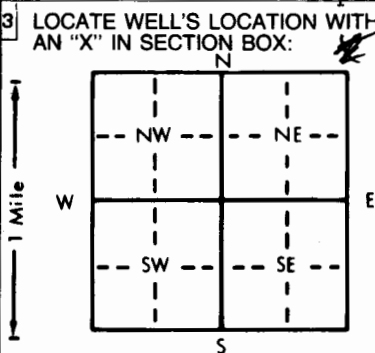

4 DEPTH OF COMPLETED WELL: 26' ft. ELEVATION: .....  
 Depth(s) Groundwater Encountered 1. 15' ft. 2. .... ft. 3. .... ft.  
 WELL'S STATIC WATER LEVEL 15' ft. below land surface measured on mo/day/yr 9-7-82  
 Pump test data: Well water was ..... ft. after ..... hours pumping ..... gpm  
 Est. Yield ..... gpm: Well water was ..... ft. after ..... hours pumping ..... gpm  
 Bore Hole Diameter 3.0 in. to ..... ft., and ..... in. to ..... ft.  
 WELL WATER TO BE USED AS: 5 Public water supply 8 Air conditioning 11 Injection well  
 1 Domestic 3 Feedlot 6 Oil field water supply 9 Dewatering 12 Other (Specify below)  
 2 Irrigation 4 Industrial 7 Lawn and garden only 10 Observation well  
 Was a chemical/bacteriological sample submitted to Department? Yes.....No. X.....; If yes, mo/day/yr sample was submitted  
 Water Well Disinfected? Yes No X

5 TYPE OF BLANK CASING USED: 5 Wrought iron 8 Concrete tile CASING JOINTS: Glued X Clamped .....  
 1 Steel 3 RMP (SR) 6 Asbestos-Cement 9 Other (specify below) Welded .....  
2 PVC 4 ABS 7 Fiberglass ..... Threaded.....  
 Blank casing diameter 8 in. to ..... ft., Dia ..... in. to ..... ft., Dia ..... in. to ..... ft.  
 Casing height above land surface 24 in., weight ..... lbs./ft. Wall thickness or gauge No. sch 40  
 TYPE OF SCREEN OR PERFORATION MATERIAL: 7 PVC 10 Asbestos-cement  
 1 Steel 3 Stainless steel 5 Fiberglass 8 RMP (SR) 11 Other (specify) .....  
 2 Brass 4 Galvanized steel 6 Concrete tile 9 ABS 12 None used (open hole)  
 SCREEN OR PERFORATION OPENINGS ARE: 5 Gauzed wrapped 8 Saw cut 11 None (open hole)  
 1 Continuous slot 3 Mill slot 6 Wire wrapped 9 Drilled holes  
 2 Louvered shutter 4 Key punched 7 Torch cut 10 Other (specify) .....  
 SCREEN-PERFORATED INTERVALS: From 15 ft. to 26 ft. From ..... ft. to ..... ft.  
 GRAVEL PACK INTERVALS: From 15 ft. to TD ft. From ..... ft. to ..... ft.

6 GROUT MATERIAL: 1 Neat cement 2 Cement grout 3 Bentonite 4 Other ? NONE  
 Grout Intervals: From ..... ft. to ..... ft. From ..... ft. to ..... ft. From ..... ft. to ..... ft.  
 What is the nearest source of possible contamination: 10 Livestock pens 14 Abandoned water well  
 1 Septic tank 4 Lateral lines 7 Pit privy 11 Fuel storage 15 Oil well/Gas well  
2 Sewer lines 5 Cess pool 8 Sewage lagoon 12 Fertilizer storage 16 Other (specify below)  
 3 Watertight sewer lines 6 Seepage pit 9 Feedyard 13 Insecticide storage  
 Direction from well? West How many feet? 200

| FROM | TO  | LITHOLOGIC LOG                      | FROM | TO | LITHOLOGIC LOG |
|------|-----|-------------------------------------|------|----|----------------|
| 0'   | 5'  | Hard Gray Clay                      |      |    |                |
| 5'   | 10' | Hard Brown Clay                     |      |    |                |
| 10'  | 15' | Yellow Clay 15' water               |      |    |                |
| 15'  | 20' | Soft Yellow Clay                    |      |    |                |
| 20'  | 24' | Clay dirty gravel - limestone chips |      |    |                |
| 24'  | 26' | Shale                               |      |    |                |
| 26'  |     | TD                                  |      |    |                |

7 CONTRACTOR'S OR LANDOWNER'S CERTIFICATION: This water well was (1) constructed, (2) reconstructed, or (3) plugged under my jurisdiction and was completed on (mo/day/year) Sept. 8, 9, 10, 1982 and this record is true to the best of my knowledge and belief. Kansas Water Well Contractor's License No. 435 This Water Well Record was completed on (mo/day/yr) Sept. 10, 1982 under the business name of John Brown & Company by (signature) John C. Brown

INSTRUCTIONS: Use typewriter or ball point pen, PLEASE PRESS FIRMLY and PRINT clearly. Please fill in blanks, underline or circle the correct answers. Send top three copies to Kansas Department of Health and Environment, Division of Environment, Environmental Geology Section, Topeka, KS 66620. Send one to WATER WELL OWNER and retain one for your records.