WATER WELL RECORD Form WWC-5 KSA 82a-1212 #10

| 1 LOCATION OF WATER WELL: County: | Fraction | Section Number | Township Number | Range Number |
|---|---|---|---|---|
| | ✓N½ NE ¼ SW ¼ | 17 | T 12 S | R 15 (E)W |

Distance and direction from nearest town or city street address of well if located within city?
West of Topeka on Nottingham Road

2 WATER WELL OWNER: M. W. Watson, Inc.
RR#, St. Address, Box # : 3333 East 21st Street
City, State, ZIP Code : Topeka, KS 66601

Board of Agriculture, Division of Water Resources
Application Number: 36000214

3 LOCATE WELL'S LOCATION WITH AN "X" IN SECTION BOX: ✓

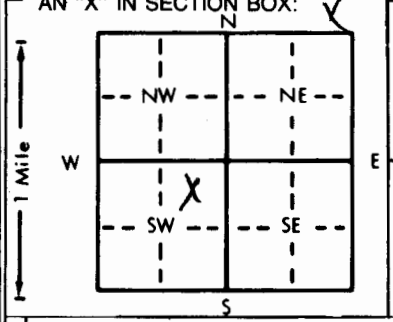


4 DEPTH OF COMPLETED WELL 26' ft. ELEVATION:
Depth(s) Groundwater Encountered 1. 14' ft. 2. ft. 3. ft.
WELL'S STATIC WATER LEVEL 14' ft. below land surface measured on mo/day/yr X 9-10-82
Pump test data: Well water was ft. after hours pumping gpm
Est. Yield gpm: Well water was ft. after hours pumping gpm
Bore Hole Diameter X 30 in. to ft., and in. to ft.
WELL WATER TO BE USED AS: 5 Public water supply 8 Air conditioning 11 Injection well
1 Domestic 3 Feedlot 6 Oil field water supply (9) Dewatering 12 Other (Specify below)
2 Irrigation 4 Industrial 7 Lawn and garden only 10 Observation well
Was a chemical/bacteriological sample submitted to Department? Yes No X; If yes, mo/day/yr sample was submitted
Water Well Disinfected? Yes No X

5 TYPE OF BLANK CASING USED: 5 Wrought iron 8 Concrete tile CASING JOINTS: Glued X Clamped
1 Steel 3 RMP (SR) 6 Asbestos-Cement 9 Other (specify below) Welded
(2) PVC 4 ABS 7 Fiberglass Threaded
Blank casing diameter X 8 in. to ft., Dia in. to ft., Dia in. to ft.
Casing height above land surface ✓ 24 in., weight lbs./ft. Wall thickness or gauge No X Sch 40
TYPE OF SCREEN OR PERFORATION MATERIAL: (7) PVC 10 Asbestos-cement
1 Steel 3 Stainless steel 5 Fiberglass 8 RMP (SR) 11 Other (specify)
2 Brass 4 Galvanized steel 6 Concrete tile 9 ABS 12 None used (open hole)
SCREEN OR PERFORATION OPENINGS ARE: 5 Gauzed wrapped (8) Saw cut 11 None (open hole)
1 Continuous slot 3 Mill slot 6 Wire wrapped 9 Drilled holes
2 Louvered shutter 4 Key punched 7 Torch cut 10 Other (specify)
SCREEN-PERFORATED INTERVALS: From X 14 ft. to 26 ft., From ft. to ft.
From ft. to ft., From ft. to ft.
GRAVEL PACK INTERVALS: From 14 ft. to TD ft., From ft. to ft.
From ft. to ft., From ft. to ft.

6 GROUT MATERIAL: 1 Neat cement 2 Cement grout 3 Bentonite (4) Other None
Grout Intervals: From X ft. to ft., From ft. to ft., From ft. to ft.
What is the nearest source of possible contamination: 10 Livestock pens 14 Abandoned water well
1 Septic tank 4 Lateral lines 7 Pit privy 11 Fuel storage 15 Oil well/Gas well
(2) Sewer lines 5 Cess pool 8 Sewage lagoon 12 Fertilizer storage 16 Other (specify below)
3 Watertight sewer lines 6 Seepage pit 9 Feedyard 13 Insecticide storage
Direction from well? X West How many feet? X 200

| FROM | TO | LITHOLOGIC LOG | FROM | TO | LITHOLOGIC LOG |
|---|---|---|---|---|---|
| 0' | 5' | Hard brown clay | | | |
| 5' | 10' | Hard brownish clay | | | Grouting Variance OKD DP 1-26-83 |
| 10' | 15' | Yellow clay 14' water | | | |
| 15' | 20' | Soft yellow clay dirty gravel & limestone chips | | | |
| 20' | 22' | Boulders | | | |
| 22' | 23' | Boulders | | | |
| 23' | 26' | Shale | | | |
| 26' | | TD | | | |

7 CONTRACTOR'S OR LANDOWNER'S CERTIFICATION: This water well was (1) constructed, (2) reconstructed, or (3) plugged under my jurisdiction and was completed on (mo/day/year) Sept. 8, 9, 10, 1982 and this record is true to the best of my knowledge and belief. Kansas Water Well Contractor's License No. 435 This Water Well Record was completed on (mo/day/yr) Sept. 10, 1982 under the business name of John Brown & Company by (signature) John C. Brown

INSTRUCTIONS: Use typewriter or ball point pen, *PLEASE PRESS FIRMLY* and *PRINT* clearly. Please fill in blanks, underline or circle the correct answers. Send top three copies to Kansas Department of Health and Environment, Division of Environment, Environmental Geology Section, Topeka, KS 66620. Send one to WATER WELL OWNER and retain one for your records.

OFFICE USE ONLY T 12 R 15 (E)W SEC. 17 NW¼ NE¼ SW¼