261 SW

Lot
Vjd

USE TYPEWRITER OR BALL POINT PEN-PRESS FIRMLY, PRINT CLEARLY.

WATER WELL RECORD
KSA 82a-1201-1215

Kansas Department of Health and Environment-Division of Environment
(Water well Contractors)
Topeka, Kansas 66620

1. Location of well:	County	Fraction	Section number	Township number	Range number
	Shawnee	SE 1/4 1/4 NE 1/4	17	T 12 S	R 15 E W

2. Distance and direction from nearest town or city: 2 SW of
Street address of well location if in city: Topeka

3. Owner of well: Bob McDowell
R.R. or street:
City, state, zip code: Topeka 3141 Wanamaker

4. Locate with "X" in section below:

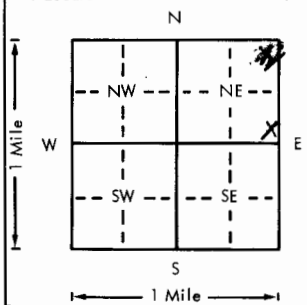

Sketch map:

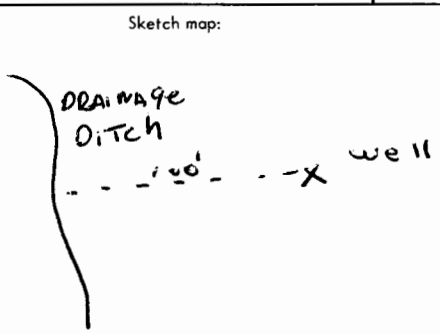

5. Type and color of material	From	To
Top Soil	0	3
Clay, Brown	3	15
gravel - loose Limestone	15	18
shale, grey	18	65
Limestone, grey	65	76
shale, grey, blk. Limestone	76	100

(Use a second sheet if needed)

6. Bore hole dia. 8 in. Completion date
Well depth 100 ft. 5-3-77

7. __ Cable tool ✓ Rotary __ Driven __ Dug
__ Hollow rod __ Jetted __ Bored __ Reverse rotary

8. Use: __ Domestic __ Public supply __ Industry
__ Irrigation __ Air conditioning __ Stock
✓ Lawn __ Oil field water __ Other

9. Casing: Material PVC Height: Above or below
Threaded ___ Welded ___ Surface 24 in.
RMP ___ PVC 9L Weight ~~2.74~~ lbs./ft. 2.74 MRC
Dia. 5 in. to 100 ft. depth Wall Thickness: inches or
Dia. ___ in. to ___ ft. depth gage No. ~~[illegible]~~ 258

10. Screen: Manufacturer's name Pumpco
Type PVC Dia. 5
Slot gauze .020 Length 10
Set between 15 ft. and 25 ft.
___ ft. and ___ ft.
Gravel pack? ✓ Size range of material .03 x .06

11. Static water level: mo./day/yr.
15 ft. below land surface Date 5-3-77

12. Pumping level below land surfaces:
___ ft. after ___ hrs. pumping ___ g.p.m.
___ ft. after ___ hrs. pumping ___ g.p.m.
Estimated maximum yield 10 g.p.m.

13. Water sample submitted: mo./day/yr.
__ Yes ✓ No Date

14. Well head completion: CAP
__ Pitless adapter 24 Inches above grade

15. Well grouted? ✓
With: ✓ Neat cement __ Bentonite __ Concrete
Depth: From 0 ft. to 10 ft.

16. Nearest source of possible contamination:
ft. 100 Direction W Type DRAINAGE
Well disinfected upon completion? ✓ Yes __ No

17. Pump: ✓ Not installed
Manufacturer's name
Model number HP Volts
Length of drop pipe ft. capacity g.p.m.
Type:
__ Submersible __ Turbine
__ Jet __ Reciprocating
__ Centrifugal __ Other

T 12 R 15 W Sec 17 1/4 NE 1/4 NE 1/4 NE 1/4

18. Elevation: 954 Km
Topography:
__ Hill
__ Slope
__ Upland
✓ Valley

19. Remarks:
OWNER TO INSTAL SLAB

20. Water well contractor's certification:
This well was drilled under my jurisdiction and this report is true to the best of my knowledge and belief.
Strader Drlg Co Inc. 182
Business name License No.
Address RT 1 Holton, Ks
Signed Dale Ashrin Date 5-5-77
Authorized representative

Forward the white, blue and pink copies to the Department of Health and Environment

Form WWC-5

MI-1023