


1 LOCATION OF WATER WELL: Fraction E W Section Number 14 Township Number T 12 S Range Number R 15 EW
 County: Shawnee NW 1/4 NE 1/4 NE 1/4

Distance and direction from nearest town or city street address of well if located within city?
corner of SW. 29th and SW. Medford Ave. - Topeka, KS

2 WATER WELL OWNER: City of Topeka - Attn: G. Schell
 RR#, St. Address, Box #: 515 S. Kansas Ave Rm 402
 City, State, ZIP Code: Topeka, Kansas 66602
 Board of Agriculture, Division of Water Resources
 Application Number: —

3 LOCATE WELL'S LOCATION WITH AN "X" IN SECTION BOX: DEPTH OF COMPLETED WELL: 20 ft. ELEVATION: 919.45
 Depth(s) Groundwater Encountered 1. 15.1 ft. 2. — ft. 3. — ft.
 WELL'S STATIC WATER LEVEL: 14.96 ft. below land surface measured on mo/day/yr 9/16/94

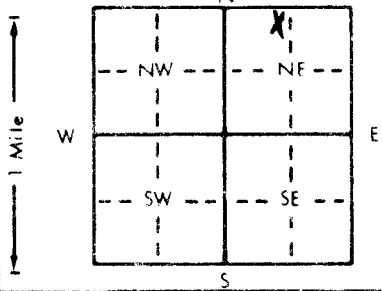

Pump test data: Well water was — ft. after — hours pumping — gpm
 Est. Yield — gpm: Well water was — ft. after — hours pumping — gpm
 Bore Hole Diameter: 8.625 in. to 20 ft., and — in. to — ft.
 WELL WATER TO BE USED AS:
 5 Public water supply 8 Air conditioning 11 Injection well
 1 Domestic 3 Feedlot 6 Oil field water supply 9 Dewatering 12 Other (Specify below)
 2 Irrigation 4 Industrial 7 Lawn and garden only 10 Monitoring well mw-3
 Was a chemical/bacteriological sample submitted to Department? Yes — No X: If yes, mo/day/yr sample was submitted —
 Water Well Disinfected? Yes — No X

5 TYPE OF BLANK CASING USED:
 1 Steel 3 RMP (SR) 6 Asbestos-Cement 9 Other (specify below) Welded —
2 PVC 4 ABS 7 Fiberglass Threading X
 Blank casing diameter: 2" in. to 10' ft. Dia — in. to — ft. Dia — in. to — ft.
 Casing height above land surface: Flush in. weight — lbs. ft. Wall thickness or gauge No. —

TYPE OF SCREEN OR PERFORATION MATERIAL:
 1 Steel 3 Stainless steel 5 Fiberglass 8 RMP (SR) 11 Other (specify) —
 2 Brass 4 Galvanized steel 6 Concrete tile 9 ABS 12 None used (open hole)

SCREEN OR PERFORATION OPENINGS ARE:
 1 Continuous slot 3 Mill slot 6 Wire wrapped 9 Drilled holes
 2 Louvered shutter 4 Key punched 7 Torch cut 10 Other (specify) —
 5 Gauzed wrapped 8 Saw cut 11 None (open hole)

SCREEN-PERFORATED INTERVALS: From 10 ft. to 20 ft. From — ft. to — ft.
SAND From 9 ft. to 20 ft. From — ft. to — ft.
GRAVEL PACK INTERVALS: From — ft. to — ft. From — ft. to — ft.

6 GROUT MATERIAL: 1 Neat cement 2 Cement grout 3 Bentonite 4 Other —
 Grout Intervals: From 6L ft. to 7 ft. From 3 ft. to 7 ft. From 9 ft. to — ft.

What is the nearest source of possible contamination:
 1 Septic tank 4 Lateral lines 7 Pit privy 10 Livestock pens 14 Abandoned water well
 2 Sewer lines 5 Cess pool 8 Sewage lagoon 11 Fuel storage 15 Oil well/Gas well
 3 Watertight sewer lines 6 Seepage pit 9 Feedyard 12 Fertilizer storage 16 Other (specify below) contaminated site
 13 Insecticide storage

Direction from well? How many feet?

FROM	TO	LITHOLOGIC LOG	FROM	TO	PLUGGING INTERVALS
<u>6L</u>	<u>.5</u>	<u>soil, silty clay, brown stiff</u>			
<u>.5</u>	<u>15</u>	<u>Silty clay, brown soft</u>			
<u>15</u>	<u>19</u>	<u>clayey sand, fine to coarse</u>			
<u>19</u>	<u>20</u>	<u>Shale, tan, dry, hard</u>			
<u>20</u>	<u>TD</u>				

FLUSH MOUNT WAIVER
09-07-94
RICHARD HARPER

7 CONTRACTOR'S OR LANDOWNER'S CERTIFICATION: This water well was (1) constructed, (2) reconstructed, or (3) plugged under my jurisdiction and was completed on (mo/day/year) 09-13-94 and this record is true to the best of my knowledge and belief. Kansas Water Well Contractor's License No. 479 This Water Well Record was completed on (mo/day/yr) 10-10-94 under the business name of EBBERTS DRILLING by (signature) Gregory Ebberts