


1 LOCATION OF WATER WELL: Fraction E N<sup>1/4</sup> W N<sup>1/4</sup> NE <sup>1/4</sup> Section Number 14 Township Number T 12 S Range Number R 15 EW  
 County: Shawnee

Distance and direction from nearest town or city street address of well if located within city?  
SW corner of SW 29th and SW Randolph Ave, Topeka, KS

2 WATER WELL OWNER: City of Topeka Attn: G. Schell  
 RR# St. Address, Box #: 515 S. Kansas Ave Rm 402 Board of Agriculture, Division of Water Resources  
 City, State, ZIP Code: Topeka, KS 66602 Application Number: ---

3 LOCATE WELL'S LOCATION WITH AN "X" IN SECTION BOX: 4 DEPTH OF COMPLETED WELL: 22.0 ft. ELEVATION: 917.60  
 Depth(s) Groundwater Encountered 1. 16.8 ft. 2. --- ft. 3. --- ft.

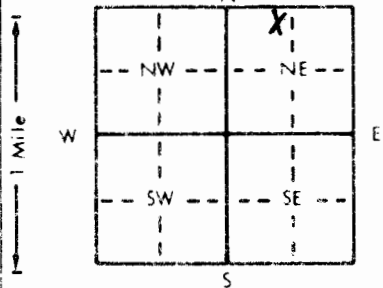

WELL'S STATIC WATER LEVEL 16.58 ft. below land surface measured on mo/day/yr 9/16/94  
 Pump test data: Well water was --- ft. after --- hours pumping --- gpm  
 Est. Yield --- gpm: Well water was --- ft. after --- hours pumping --- gpm  
 Bore Hole Diameter 8.625 in. to 22.0 ft. and --- in. to --- ft.  
 WELL WATER TO BE USED AS:  
 5 Public water supply 8 Air conditioning 11 Injection well  
 1 Domestic 3 Feedlot 6 Oil field water supply 9 Dewatering 12 Other (Specify below)  
 2 Irrigation 4 Industrial 7 Lawn and garden only 10 Monitoring well mw-5  
 Was a chemical/bacteriological sample submitted to Department? Yes --- No X; If yes, mo/day/yr sample was submitted ---  
 Water Well Disinfected? Yes --- No X

5 TYPE OF BLANK CASING USED:  
 1 Steel 3 RMP (SR) 5 Wrought iron 8 Concrete tile CASING JOINTS: Glued --- Clamped ---  
2 PVC 4 ABS 6 Asbestos-Cement 9 Other (specify below) Welded ---  
 7 Fiberglass Threaded X

Blank casing diameter: 2" in. to 12.0' ft. Dia --- in. to --- ft. Dia --- in. to --- ft.  
 Casing height above land surface: Flush in., weight --- lbs./ft. Wall thickness or gauge No. ---

TYPE OF SCREEN OR PERFORATION MATERIAL:  
 1 Steel 3 Stainless steel 5 Fiberglass 8 RMP (SR) 10 Asbestos-cement  
 2 Brass 4 Galvanized steel 6 Concrete tile 9 ABS 11 Other (specify) ---  
 12 None used (open hole)

SCREEN OR PERFORATION OPENINGS ARE:  
 1 Continuous slot 3 Mill slot 5 Gauzed wrapped 8 Saw cut 11 None (open hole)  
 2 Louvered shutter 4 Key punched 6 Wire wrapped 9 Drilled holes  
 7 Torch cut 10 Other (specify) ---

SCREEN-PERFORATED INTERVALS: From 12.0 ft. to 22.0 ft. From --- ft. to --- ft.  
 From --- ft. to --- ft. From --- ft. to --- ft.  
 SAND GRAVEL PACK INTERVALS: From --- ft. to 11.0 ft. From --- ft. to 22.0 ft.  
 From --- ft. to --- ft. From --- ft. to --- ft.

6 GROUT MATERIAL:  
 1 Neat cement 2 Cement grout 3 Bentonite 4 Other ---  
 Grout Intervals: From GL ft. to 9 ft. From 9 ft. to 11 ft. From --- ft. to --- ft.

What is the nearest source of possible contamination:  
 1 Septic tank 4 Lateral lines 7 Pit privy 10 Livestock pens 14 Abandoned water well  
 2 Sewer lines 5 Cess pool 8 Sewage lagoon 11 Fuel storage 15 Oil well/Gas well  
 3 Watertight sewer lines 6 Seepage pit 9 Feedyard 12 Fertilizer storage 16 Other (specify below) contaminated site  
 13 Insecticide storage

Direction from well? How many feet?

FROM	TO	LITHOLOGIC LOG	FROM	TO	PLUGGING INTERVALS
<u>GL</u>	<u>.5</u>	<u>soil, silty clay, brown</u>			
<u>.5</u>	<u>10.0</u>	<u>silty clay (cl) gray, very stiff</u>			
<u>10.0</u>	<u>17.0</u>	<u>silty clay (cl) gray-dk gray</u>			
<u>17.0</u>	<u>19.0</u>	<u>Limestone, dry, hard</u>			
<u>19.0</u>	<u>22.0</u>	<u>Shale, gray, dry</u>			
<u>22.0</u>	<u>TD</u>				

FLUSH MOUNT WAIVER  
09-07-94  
RICHARD HARPER

7 CONTRACTOR'S OR LANDOWNER'S CERTIFICATION: This water well was (1) constructed, (2) reconstructed, or (3) plugged under my jurisdiction and was completed on (mo/day/year) 09-14-94 and this record is true to the best of my knowledge and belief. Kansas Water Well Contractor's License No. 479 This Water Well Record was completed on (mo/day/yr) 10-10-94 under the business name of EBBITTS DRILLING by (signature) Shogan Ebbitts