


1 LOCATION OF WATER WELL: Fraction SW 1/4 NE 1/4 NE 1/4 Section Number 14 Township Number T 12 S Range Number R 15 E  
 County: Shawnee

Distance and direction from nearest town or city street address of well if located within city?  
S of intersection of SW 29th and SW Medford Ave, approx 200'

2 WATER WELL OWNER: City of Topeka ATTN: G Schell  
 RR#, St. Address, Box #: 515 S. Kansas Rm 402  
 City, State, ZIP Code: Topeka, KS 66602  
 Board of Agriculture, Division of Water Resources  
 Application Number: —

3 LOCATE WELL'S LOCATION WITH AN "X" IN SECTION BOX: DEPTH OF COMPLETED WELL: 22.5 ft. ELEVATION: 921.20  
 Depth(s) Groundwater Encountered: 1. 15.5 ft. 2. — ft. 3. — ft.  
 WELL'S STATIC WATER LEVEL: 16.06 ft. below land surface measured on mo/day/yr 9/16/94

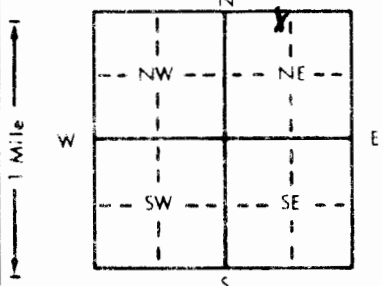

Pump test data: Well water was — ft. after — hours pumping — gpm  
 Est. Yield — gpm Well water was — ft. after — hours pumping — gpm  
 Bore Hole Diameter 8.625 in. to 22.5 ft. and — in. to — ft.  
 WELL WATER TO BE USED AS:  
 5 Public water supply 8 Air conditioning 11 Injection well  
 1 Domestic 3 Feedlot 6 Oil field water supply 9 Dewatering 12 Other (Specify below)  
 2 Irrigation 4 Industrial 7 Lawn and garden only 10 Monitoring well mw-7  
 Was a chemical/bacteriological sample submitted to Department? Yes — No X If yes, mo/day/yr sample was submitted —  
 Water Well Disinfected? Yes — No X

5 TYPE OF BLANK CASING USED:  
 1 Steel 3 RMP (SR) 5 Wrought iron 8 Concrete tile CASING JOINTS: Glued — Clamped —  
2 PVC 4 ABS 6 Asbestos-Cement 9 Other (specify below) Welded —  
 Blank casing diameter 2" in. to 12.5 ft. Dia. — in. to — ft. Dia. — in. to — ft.  
 Casing height above land surface Flush in. weight Sch. 40 lbs. ft. Wall thickness or gauge No. —  
 TYPE OF SCREEN OR PERFORATION MATERIAL:  
 1 Steel 3 Stainless steel 5 Fiberglass 8 RMP (SR) 11 Other (specify) —  
 2 Brass 4 Galvanized steel 6 Concrete tile 9 ABS 12 None used (open hole)

SCREEN OR PERFORATION OPENINGS ARE:  
 1 Continuous slot 3 Mill slot 5 Gauzed wrapped 8 Saw cut 11 None (open hole)  
 2 Louvered shutter 4 Key punched 6 Wire wrapped 9 Drilled holes  
 7 Torch cut 10 Other (specify) —  
 SCREEN-PERFORATED INTERVALS: From 12.5 ft. to 22.5 ft. From — ft. to — ft.  
 From — ft. to — ft. From — ft. to — ft.  
 SAND GRAVEL PACK INTERVALS: From 12.5 ft. to 22.5 ft. From — ft. to — ft.  
 From — ft. to — ft. From — ft. to — ft.

6 GROUT MATERIAL: 1 Neat cement 2 Cement grout 3 Bentonite 4 Other —  
 Grout Intervals: From 2 GL ft. to 10.5 ft. From 3 ft. to 10.5 ft. From 12.5 ft. to — ft.  
 What is the nearest source of possible contamination:  
 1 Septic tank 4 Lateral lines 7 Pit privy 10 Livestock pens 14 Abandoned water well  
 2 Sewer lines 5 Cess pool 8 Sewage lagoon 11 Fuel storage 15 Oil well/Gas well  
 3 Watertight sewer lines 6 Seepage pit 3 Feedyard 12 Fertilizer storage 16 Other (specify below)  
 13 Insecticide storage contaminated site  
 Direction from well? How many feet? —

FROM	TO	LITHOLOGIC LOG	FROM	TO	PLUGGING INTERVALS
<u>GL</u>	<u>1.0</u>	<u>Soil, clayey silt, brown</u>			
<u>1.0</u>	<u>12.0</u>	<u>Gravelly clay, brown silty clay</u>			
<u>12.0</u>	<u>15.0</u>	<u>Gravelly clay</u>			
<u>15.0</u>	<u>21.5</u>	<u>Silty clay</u>			
<u>21.5</u>	<u>22.5</u>	<u>Limestone</u>			
<u>22.5</u>	<u>TD</u>				

FLUSH MOUNT WAIVER  
09-07-94  
RICHARD HARPER

7 CONTRACTOR'S OR LANDOWNER'S CERTIFICATION: This water well was (1) constructed, (2) reconstructed, or (3) plugged under my jurisdiction and was completed on (mo/day/year) 09-15-94 and this record is true to the best of my knowledge and belief. Kansas Water Well Contractor's License No. 479 This Water Well Record was completed on (mo/day/yr) 10-10-94 under the business name of EBBERTS DRILLING by (signature) Logan Ebberts