


1 LOCATION OF WATER WELL: Fraction SW 1/4 NW 1/4 NW 1/4 Section Number 13 Township Number T 12 S Range Number R 16 E/W
 County: Shawnee

Distance and direction from nearest town or city street address of well if located within city?

31st & Topeka Blvd. Topeka, Ks.

2 WATER WELL OWNER: Phillip Frick/ Fowlston-Siefkin Law Office
 RR#, St. Address, Box #: 700 4th Financial Ctr. Board of Agriculture, Division of Water Resources
 City, State, ZIP Code: Wichita, Ks. 67202 Application Number:

3 LOCATE WELL'S LOCATION WITH AN "X" IN SECTION BOX:

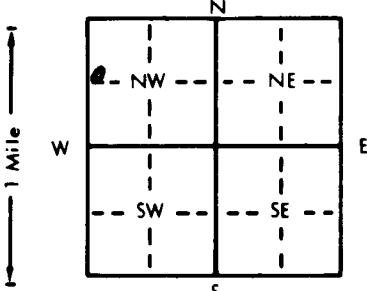

4 DEPTH OF COMPLETED WELL: 20' ft. ELEVATION: ft.

Depth(s) Groundwater Encountered 1. 15' ft. 2. ft. 3. ft.
 WELL'S STATIC WATER LEVEL 10.60 ft. below land surface measured on mo/day/yr 9-2-95

Pump test data: Well water was ft. after hours pumping gpm
 Est. Yield gpm; Well water was ft. after hours pumping gpm

Bore Hole Diameter: 8 1/2" in. to 20' ft., and in. to ft.

- WELL WATER TO BE USED AS:
- 5 Public water supply
 - 8 Air conditioning
 - 11 Injection well
 - 1 Domestic
 - 3 Feedlot
 - 6 Oil field water supply
 - 9 Dewatering
 - 12 Other (Specify below)
 - 2 Irrigation
 - 4 Industrial
 - 7 Lawn and garden only
 - 10 Monitoring well

Was a chemical/bacteriological sample submitted to Department? Yes No X; If yes, mo/day/yr sample was submitted
 Water Well Disinfected? Yes No

5 TYPE OF BLANK CASING USED:

- 1 Steel
- 3 RMP (SR)
- 5 Wrought iron
- 8 Concrete tile
- CASING JOINTS: Glued Clamped

2 PVC
 Blank casing diameter 2.375 in. to S' ft., Dia in. to ft., Dia in. to ft.

Casing height above land surface Flush Mt. in., weight lbs./ft. Wall thickness or gauge No. SDR-13

TYPE OF SCREEN OR PERFORATION MATERIAL:

- 1 Steel
- 3 Stainless steel
- 5 Fiberglass
- 8 RMP (SR)
- 11 Other (specify)
- 2 Brass
- 4 Galvanized steel
- 6 Concrete tile
- 9 ABS
- 12 None used (open hole)

SCREEN OR PERFORATION OPENINGS ARE:

- 1 Continuous slot
- 3 Mill slot
- 5 Gauzed wrapped
- 8 Saw cut
- 11 None (open hole)
- 2 Louvered shutter
- 4 Key punched
- 6 Wire wrapped
- 9 Drilled holes
- 7 Torch cut
- 10 Other (specify)

SCREEN-PERFORATED INTERVALS: From 20' ft. to 5' ft., From ft. to ft.

GRAVEL PACK INTERVALS: From 20' ft. to 4' ft., From ft. to ft.

From ft. to ft., From ft. to ft.

From ft. to ft., From ft. to ft.

6 GROUT MATERIAL: 1 Neat cement 2 Cement grout 3 Bentonite 4 Other

Grout Intervals: From 4' ft. to 3' ft., From 3' ft. to 0' ft., From ft. to ft.

What is the nearest source of possible contamination:

- 1 Septic tank
- 4 Lateral lines
- 7 Pit privy
- 11 Fuel storage
- 15 Oil well/Gas well
- 2 Sewer lines
- 5 Cess pool
- 8 Sewage lagoon
- 12 Fertilizer storage
- 16 Other (specify below)
- 3 Watertight sewer lines
- 6 Seepage pit
- 9 Feedyard
- 13 Insecticide storage

Direction from well? East How many feet? 10'

FROM	TO	LITHOLOGIC LOG	FROM	TO	PLUGGING INTERVALS
0	.50	Asphalt			
.50	8.50	Med dk brn clay, moist, no odor, ls.rx. gravel frag.			
8.50	10.25	Yellow gray-olive gray clayey shale, moist to dry, no odor, oxide staining, fraible.			
10.25	16	Dk gray clay, tight, sewer odor, oxides, fraible.			
16	20	Yellow-gray yellow shale, dry to moist, fraible, no odor.			

F.H. OK'd by Don Taylor

7 CONTRACTOR'S OR LANDOWNER'S CERTIFICATION: This water well was (constructed) (2) reconstructed, or (3) plugged under my jurisdiction and was completed on (mo/day/year) 8-27-95 and this record is true to the best of my knowledge and belief. Kansas Water Well Contractor's License No. 539 This Water Well Record was completed on (mo/day/yr) 9-5-95 under the business name of JB Environmental Drilling by (signature) James Bieker