


WATER WELL RECORD Form WWC-5 KSA 82a-1212

1] LOCATION OF WATER WELL: County: Shawnee Fraction: SE 1/4 NW 1/4 NW 1/4 Section Number: 18 Township Number: T 12 S Range Number: R 16 EW

Distance and direction from nearest town or city street address of well if located within city? 3020 SW Topeka Boulevard, Topeka

2] WATER WELL OWNER: Winners Circle Partnership RR#, St. Address, Box #: 700 4th Financial Center City, State, ZIP Code: Wichita, KS 67202 Board of Agriculture, Division of Water Resources Application Number:

3] LOCATE WELL'S LOCATION WITH AN "X" IN SECTION BOX: 4] DEPTH OF COMPLETED WELL: 25 ft. ELEVATION:

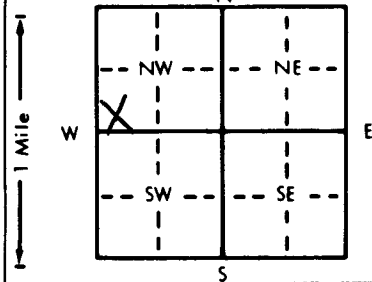

Depth(s) Groundwater Encountered 1. 13.07 ft. 2. ft. 3. ft. WELL'S STATIC WATER LEVEL 13.07 ft. below land surface measured on mo/day/yr Pump test data: Well water was ft. after hours pumping gpm Est. Yield gpm: Well water was ft. after hours pumping gpm Bore Hole Diameter 8 in. to 25 ft., and in. to ft. WELL WATER TO BE USED AS: 5 Public water supply 8 Air conditioning 11 Injection well 1 Domestic 3 Feedlot 6 Oil field water supply 9 Dewatering 12 Other (Specify below) 2 Irrigation 4 Industrial 7 Lawn and garden only 10 Monitoring well Was a chemical/bacteriological sample submitted to Department? Yes No X If yes, mo/day/yr sample was submitted Water Well Disinfected? Yes No X

5] TYPE OF BLANK CASING USED: 1 Steel 3 RMP (SR) 5 Wrought iron 8 Concrete tile CASING JOINTS: Glued Clamped 2 PVC 4 ABS 6 Asbestos-Cement 9 Other (specify below) Welded Threaded X

Blank casing diameter 2 in. to 0.5 ft., Dia. in. to ft., Dia. in. to ft. Casing height above land surface 0.716 in., weight 116 lbs./ft. Wall thickness or gauge No. 154

TYPE OF SCREEN OR PERFORATION MATERIAL: 1 Steel 3 Stainless steel 5 Fiberglass 8 RMP (SR) 10 Asbestos-cement 2 Brass 4 Galvanized steel 6 Concrete tile 9 ABS 11 Other (specify) 12 None used (open hole)

SCREEN OR PERFORATION OPENINGS ARE: 1 Continuous slot 3 Mill slot 5 Gauzed wrapped 8 Saw cut 11 None (open hole) 2 Louvered shutter 4 Key punched 6 Wire wrapped 9 Drilled holes 7 Torch cut 10 Other (specify)

SCREEN-PERFORATED INTERVALS: From 5 ft. to 25 ft., From ft. to ft. GRAVEL PACK INTERVALS: From 4 ft. to 25 ft., From ft. to ft.

6] GROUT MATERIAL: 1 Neat cement 2 Cement grout 4 3 Bentonite 4 Other Grout Intervals: From 3 ft. to 0 ft., From 4 ft. to 3 ft., From ft. to ft.

What is the nearest source of possible contamination: 1 Septic tank 4 Lateral lines 7 Pit privy 10 Livestock pens 14 Abandoned water well 2 Sewer lines 5 Cess pool 8 Sewage lagoon 11 Fuel storage 15 Oil well/Gas well 3 Watertight sewer lines 6 Seepage pit 9 Feedyard 12 Fertilizer storage 16 Other (specify below) contaminated site 13 Insecticide storage

Direction from well? How many feet?

Table with columns: FROM, TO, LITHOLOGIC LOG, FROM, TO, PLUGGING INTERVALS. Entries include: 0 TO 10.5 Silty clay; 10.5 TO 24 silty clay, weathered shale; 24 TO 25 shale.

7] CONTRACTOR'S OR LANDOWNER'S CERTIFICATION: This water well was (1) constructed, (2) reconstructed, or (3) plugged under my jurisdiction and was completed on (mo/day/year) 8-5-98 and this record is true to the best of my knowledge and belief. Kansas Water Well Contractor's License No. 554 This Water Well Record was completed on (mo/day/yr) 9-3-98 under the business name of Woofter Pumps Well, Inc. by (signature) Jay C. Woofter