

WATER WELL RECORD Form WWC-5 KSA 82a-1212


1 LOCATION OF WATER WELL: County: SHAWNEE	Fraction SE 1/4 NE 1/4 SE 1/4	Section Number 8	Township Number T 12 S	Range Number R 16 EW
--	----------------------------------	---------------------	---------------------------	-------------------------

Distance and direction from nearest town or city street address of well if located within city?

2701 SE.CALIFORNIA, AVE TOPEKA, KS

MW#5

2 WATER WELL OWNER: COASTAL MART, INC
 RR#, St. Address, Box # : C/O DEBBIE HARRIS 9 GREENWAY PLAZA Board of Agriculture, Division of Water Resources
 City, State, ZIP Code : SUITE 2810 HOUSTON, TX 77046 Application Number:

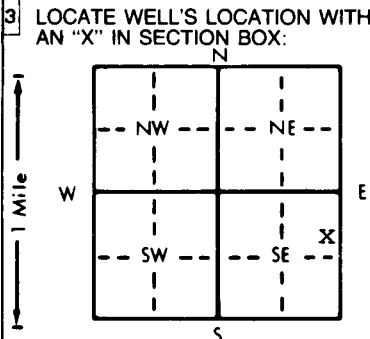

4 DEPTH OF COMPLETED WELL 22 ft. ELEVATION:

Depth(s) Groundwater Encountered 1. ft. 2. ft. 3. ft.

WELL'S STATIC WATER LEVEL ft. below land surface measured on mo/day/yr

Pump test data: Well water was ft. after hours pumping gpm

Est. Yield gpm: Well water was ft. after hours pumping gpm

Bore Hole Diameter 7 1/4 in. to 22 ft. and in. to ft.

WELL WATER TO BE USED AS: 5 Public water supply 8 Air conditioning 11 Injection well

1 Domestic 3 Feedlot 6 Oil field water supply 9 Dewatering 12 Other (Specify below)

2 Irrigation 4 Industrial 7 Lawn and garden only X 0 Monitoring well

Was a chemical/bacteriological sample submitted to Department? Yes No ; If yes, mo/day/yr sample was submitted

Water Well Disinfected? Yes No

5 TYPE OF BLANK CASING USED:

1 Steel	3 RMP (SR)	5 Wrought iron	8 Concrete tile	CASING JOINTS: Glued Clamped
X 2 PVC	4 ABS	6 Asbestos-Cement	9 Other (specify below)	Welded
		7 Fiberglass		X Threaded

Blank casing diameter 2 in. to ft. Dia in. to ft. Dia in. to ft.

Casing height above land surface 0 in., weight sched 40 lbs./ft. Wall thickness or gauge No.

TYPE OF SCREEN OR PERFORATION MATERIAL:

1 Steel	3 Stainless steel	5 Fiberglass	X PVC	10 Asbestos-cement
2 Brass	4 Galvanized steel	6 Concrete tile	8 RMP (SR)	11 Other (specify)
			9 ABS	12 None used (open hole)

SCREEN OR PERFORATION OPENINGS ARE:

1 Continuous slot	X Mill slot 0.10	5 Gauzed wrapped	8 Saw cut	11 None (open hole)
2 Louvered shutter	4 Key punched	6 Wire wrapped	9 Drilled holes	
		7 Torch cut	10 Other (specify)	

SCREEN-PERFORATED INTERVALS: From 22 ft. to 12 ft. From ft. to ft.

GRAVEL PACK INTERVALS: From 22 ft. to 10 ft. From ft. to ft.

6 GROUT MATERIAL: 1 Neat cement X 2 Cement grout X 3 Bentonite 4 Other

Grout Intervals: From 7 ft. to 2.5 ft., From 10 ft. to 7 ft. From ft. to ft.

What is the nearest source of possible contamination:

1 Septic tank	4 Lateral lines	7 Pit privy	10 Livestock pens	14 Abandoned water well
X 2 Sewer lines	5 Cess pool	8 Sewage lagoon	11 Fuel storage	15 Oil well/Gas well
3 Watertight sewer lines	6 Seepage pit	9 Feedyard	12 Fertilizer storage	16 Other (specify below)
			13 Insecticide storage	

Direction from well? east How many feet? 22'

FROM	TO	LITHOLOGIC LOG	FROM	TO	PLUGGING INTERVALS
0	6"	CONCRETE			
6"	5	TOPSOIL TO BRN PLASTIC CLAY			
5	12	BRN TAN CLAY			
12	18	OLIVE TO TAN MOIST CLAY			
18	20	TAN WEATHEDRED CLAY			
20	22	WEATHERED TAN SHALE			

7 CONTRACTOR'S OR LANDOWNER'S CERTIFICATION: This water well was (X) constructed, (2) reconstructed, or (3) plugged under my jurisdiction and was completed on (mo/day/year) 1-23-98 and this record is true to the best of my knowledge and belief. Kansas Water Well Contractor's License No. 575 This Water Well Record was completed on (mo/day/yr) 2-9-98 under the business name of KURTZ ENVIRONMENTAL SERVICE by (signature)

OFFICE USE ONLY
T
R
EW
SEC.
1/4
1/4
1/4