

WATER WELL RECORD Form WWC-5 KSA 82a-1212


1 LOCATION OF WATER WELL: County: SHAWNEE	Fraction SE 1/4 NE 1/4 SE 1/4	Section Number 8	Township Number T 12 S	Range Number R 16 <u>EW</u>
---	---	----------------------------	----------------------------------	---------------------------------------

Distance and direction from nearest town or city street address of well if located within city?

2701 SE. CALIFORNIA, AVE TOPEKA, KS

MW#6

2 WATER WELL OWNER: COASTAL MART, INC RR#, St. Address, Box #: C/O DEBBIE HARRIS 9 GREENWAY PLAZA City, State, ZIP Code: SUITE 2810 HOUSTON, TX 77046	Board of Agriculture, Division of Water Resources Application Number:
--	--

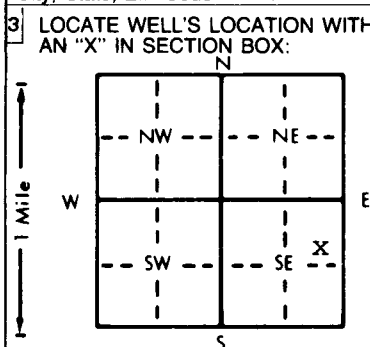

4 DEPTH OF COMPLETED WELL: 20 ft. ELEVATION:
Depth(s) Groundwater Encountered 1. ft. 2. ft. 3. ft.
WELL'S STATIC WATER LEVEL ft. below land surface measured on mo/day/yr
Pump test data: Well water was ft. after hours pumping gpm
Est. Yield gpm: Well water was ft. after hours pumping gpm
Bore Hole Diameter: 7/4 in. to 20 ft., and in. to ft.
WELL WATER TO BE USED AS:
1 Domestic 3 Feedlot 6 Oil field water supply 9 Dewatering 12 Other (Specify below)
2 Irrigation 4 Industrial 7 Lawn and garden only X10 Monitoring well
Was a chemical/bacteriological sample submitted to Department? Yes No; If yes, mo/day/yr sample was submitted
Water Well Disinfected? Yes No

5 TYPE OF BLANK CASING USED:	5 Wrought iron	8 Concrete tile	CASING JOINTS: Glued Clamped
1 Steel	3 RMP (SR)	6 Asbestos-Cement	9 Other (specify below)
X2 PVC	4 ABS	7 Fiberglass	Welded
Blank casing diameter: 2 in. to 10 ft., Dia in. to ft., Dia in. to ft.			X Threaded
Casing height above land surface: 0 in., weight sched 40 lbs./ft. Wall thickness or gauge No.			
TYPE OF SCREEN OR PERFORATION MATERIAL:	X7 PVC	10 Asbestos-cement	
1 Steel	3 Stainless steel	5 Fiberglass	8 RMP (SR)
2 Brass	4 Galvanized steel	6 Concrete tile	9 ABS
SCREEN OR PERFORATION OPENINGS ARE:	5 Gauzed wrapped	8 Saw cut	11 None (open hole)
1 Continuous slot	X3 Mill slot 0.10	6 Wire wrapped	9 Drilled holes
2 Louvered shutter	4 Key punched 20	7 Torch cut 10	10 Other (specify)
SCREEN-PERFORATED INTERVALS: From ft. to ft., From ft. to ft.			
GRAVEL PACK INTERVALS: From 20 ft. to 8 ft., From ft. to ft.			

6 GROUT MATERIAL:	1 Neat cement	X 2 Cement grout	X 3 Bentonite	4 Other
Grout Intervals: From 6 ft. to -.03 ft., From 8 ft. to 6 ft., From ft. to ft.				
What is the nearest source of possible contamination:	10 Livestock pens	14 Abandoned water well		
1 Septic tank	4 Lateral lines	7 Pit privy	11 Fuel storage	15 Oil well/Gas well
2 Sewer lines	5 Cess pool	8 Sewage lagoon	12 Fertilizer storage	16 Other (specify below)
X 3 Watertight sewer lines	6 Seepage pit	9 Feedyard	13 Insecticide storage	
Direction from well? east			How many feet? 45'	

FROM	TO	LITHOLOGIC LOG	FROM	TO	PLUGGING INTERVALS
0	4"	ASPHALT			
4"	9"	CONCRETE			
(9"	1.5	ROCK BASE			
1.5	5	BRN PLASTIC CLAY			
5	10	BRN TO TAN CLAY			
10	18	TAN TO OLIVE CLAY MOIST			
18	20	TAN WEATHERED SHALE			

7 CONTRACTOR'S OR LANDOWNER'S CERTIFICATION: This water well was (1) constructed, (2) reconstructed, or (3) plugged under my jurisdiction and was completed on (mo/day/year) 1-23-98 and this record is true to the best of my knowledge and belief. Kansas Water Well Contractor's License No. 575 . This Water Well Record was completed on (mo/day/yr) 2-9-98 under the business name of KURTZ ENVIRONMENTAL SERVICE by (signature) <i>[Signature]</i>

OFFICE USE ONLY
T
R
EW
SEC.
1/4
1/4
1/4