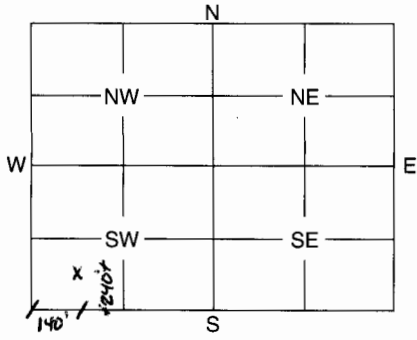


1	LOCATION OF WATER WELL:	Fraction SW Corner SW 1/4 1/4 1/4	Section Number 30	Township Number T-12-S	Range Number R-16-E EW
---	-------------------------	---	----------------------	---------------------------	---------------------------

Distance and direction from nearest town or city street address of well if located within city?

5145 SW Topeka Blvd

2	WATER WELL OWNER: AG Tollefson & Co, Inc. P.O. Box 1036 Topeka, Ks 66601	Board of Agriculture, Division of Water Resources Application Number:
---	--	--

3	MARK WELL'S LOCATION WITH AN "X" IN SECTION BOX: 	4	DEPTH OF WELL 10 ft. WELL'S STATIC WATER LEVEL 3-4' ft. WELL WAS USED AS: <ul style="list-style-type: none"> <input checked="" type="radio"/> 1 Domestic <input type="radio"/> 2 Irrigation <input type="radio"/> 3 Feedlot <input type="radio"/> 4 Industrial <input type="radio"/> 5 Public Water Supply <input type="radio"/> 6 Oil Field Water Supply <input type="radio"/> 7 Domestic (Lawn & Garden) <input type="radio"/> 8 Air Conditioning <input type="radio"/> 9 Dewatering <input type="radio"/> 10 Monitoring Well <input type="radio"/> 11 Injection Well <input type="radio"/> 12 Other
---	--	---	---

Was a chemical / bacteriological sample submitted to Department? Yes No
If yes, mo/day/yr sample was submitted

Water Well Disinfected: Yes No

5	TYPE OF BLANK CASING USED: <ul style="list-style-type: none"> 1 Steel 2 PVC 3 RMP (SR) 4 ABS 5 Wrought 6 Asbestos-Cement 7 Fiberglass 8 Concrete Tile <input checked="" type="radio"/> 9 Other (Specify below) Hand Mixed Mortar
---	--

Blank casing diameter 4.8 in. Was casing pulled? Yes No If yes, how much

Casing height above or below land surface At Ground Level in.

6	GROUT PLUG MATERIAL: 1 Neat cement <input checked="" type="radio"/> 2 Cement grout 3 Bentonite 4 Other
---	--


Grout Plug Intervals: From -9 ft. to -10 ft., From ft. to ft., From to ft.

What is the nearest source of possible contamination:

- 1 Septic tank
- 2 Sewer lines
- 3 Watertight sewer lines
- 4 Lateral lines
- 5 Cess pool
- 6 Seepage pit
- 7 Pit privy
- 8 Sewage lagoon
- 9 Feedyard
- 10 Livestock pens
- 11 Fuel storage
- 12 Fertilizer storage
- 13 Insecticide storage
- 14 Abandoned water well
- 15 Oil well/Gas well
- 16 Other (specify below)

Direction from well? North How many feet? 25'-40'

FROM	TO	PLUGGING MATERIALS
-17'	-10'	Sand Fill
-10'	-9'	Cement Grout (Top of Existing Grade)
-9'	0'	Clay Fill (Top of Proposed Grade)

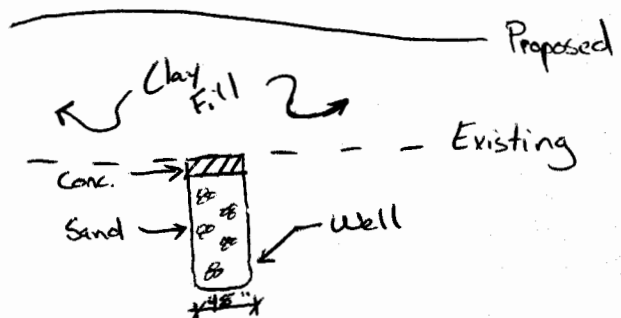

7	CONTRACTOR'S OF LANDOWNER'S CERTIFICATION: This water well was plugged under my jurisdiction and was completed on (mo/day/year) <u>10-17-05</u> and this record is true to the best of my knowledge and belief. Kansas Water Well Contractor's License No. This Water Well Record was completed on (mo/day/year) under the business name of by (signature) <u>James P. M. Maul</u>
---	---

INSTRUCTIONS: Use typewriter or ball point pen. Please press firmly and print clearly. Please fill in blanks, underline or circle the correct answers. Send top three copies to Kansas Department of Health and Environment, Bureau of Water, Geology Section, 1000 SW Jackson St., Ste. 420, Topeka, Kansas 66612-1367. Telephone: 785/296-5522. Send one to Water Well Owner and retain one for your records.