


1 LOCATION OF WATER WELL: County: Shawnee Fraction: NW 1/4 NE 1/4 SW 1/4 Section Number: 6 Township Number: T 12 S Range Number: R 16

Distance and direction from nearest town or city street address of well if located within city?

1732 SW Topeka Boulevard, Topeka, Kansas

2 WATER WELL OWNER: Capital City Oil Company RR#: P.O. Box 618 City, State, ZIP Code: Topeka, Kansas 66601

Board of Agriculture, Division of Water Resources Application Number:

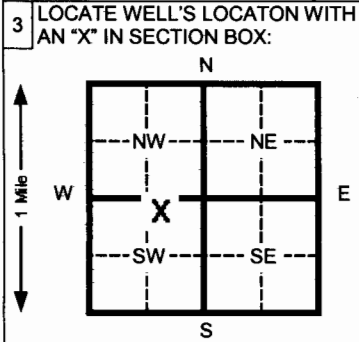

3 LOCATE WELL'S LOCATION WITH AN "X" IN SECTION BOX: 4 DEPTH OF COMPLETED WELL: 20.0 ft. ELEVATION: 11.5 ft. WELL'S STATIC WATER LEVEL: 7.75 ft. below land surface measured on 03/21/07

5 TYPE OF BLANK CASING USED: 1 Steel 2 PVC 3 RMP (SR) 4 ABS 5 Wrought Iron 6 Asbestos-Cement 7 Fiberglass 8 Concrete tile 9 Other (specify below) CASING JOINTS: Glued Clamped Welded Threaded X

TYPE OF SCREEN OR PERFORATION MATERIAL: 1 Steel 2 Brass 3 Stainless steel 4 Galvanized steel 5 Fiberglass 6 Concrete tile 7 PVC 8 RMP (SR) 9 ABS 10 Asbestos-cement 11 Other (specify) 12 None used (open hole)

6 GROUT MATERIAL: 1 Neat cement 2 Cement grout 3 Bentonite 4 Other Grout Intervals: From 0.0 ft. to 1.0 ft. From 1.0 ft. to 3.0 ft. Direction from well? Southwest How many feet? 60

LITHOLOGIC LOG table with columns FROM, TO, CODE, and description of soil layers: Asphalt, Gray brown very silty clay, very firm, moist, Dark brown very silty clay, laminated, very firm, moist, Dark brown very silty clay, laminated, very firm, moist, discolored gray-blue I/P, trace hydrocarbon odor, Dark brown very silty clay, laminated, very firm, moist-very moist, discolored blue-gray, Strong hydrocarbon odor.

7 CONTRACTOR'S OR LANDOWNER'S CERTIFICATION: This water well was (1) constructed, (2) reconstructed, or (3) plugged under my jurisdiction and was completed on (mo/day/yr) 03/21/07 and this record is true to the best of my knowledge and belief. Kansas Water Well Contractor's License No. 692 This Water Well Record was completed on (mo/day/yr) 03/29/07 under the business name of Quad State Services, Inc. by (signature)

OFFICE USE ONLY

T R

SEC