

KANSAS DEPARTMENT OF TRANSPORTATION

COUNTY *Shawnee* PROJECT NO. 40-89K2386-01 BRIDGE NO. 21.65


DESCRIPTION *Stinson Creek* STA. 187462 55'2"

GEOLOGIST *L. Myers* VERTICAL SCALE 1" = 10' DATE 7-17-55

NW NW 1-12-16E


BIT TYPE & NO.	GEOLOGIC NAME	GEOLOGIC COLUMN	GROUNDWATER ELEVATION	DEPTH	ELEVATION	GEOLOGIC DESCRIPTION AND REMARKS	UNCONFINED COMPRESSION	STANDARD PENETRATION OR CASING DRIVE	
								BLOWS	ELEV.
				0'	887.1	THE			
					880				
				18'	876				
					868.7				
				28'	862.2	Shale, weathered	866.2	3.9	
					863.3		865.6		5.9
					867.1				
					861.4	Shale, Gray	861.4	9.6	
					859.7	With a	859.7	10.6	
					857.6	thin coal seam	857.6	13.2	
					852.8	and a few (small)	852.8	16.7	
					852.6	limestone	852.6	17.3	
						stringers			
					847.9		847.9	0.8	
					844.0		844.0	13.6	
				43'	840.0				
					840				
					830				
						Core			
						1	5'	49	47
						2	2'	23	62
						3	5'	48	90
						4	5'	52	44
						5	5'	51	40

N
Oil Mantle
AT Core
Tennissh. Fm.

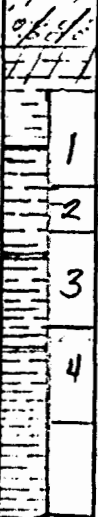

Core	CW	Recor	RQT %
1	5'	49	47
2	2'	23	62
3	5'	48	90
4	5'	52	44
5	5'	51	40

40-89 K 2386-01
 STINSON CREEK BRIDGE REPLACEMENT
 BR. NO. 21.65 STA. 186+60
 SHAWNEE COUNTY

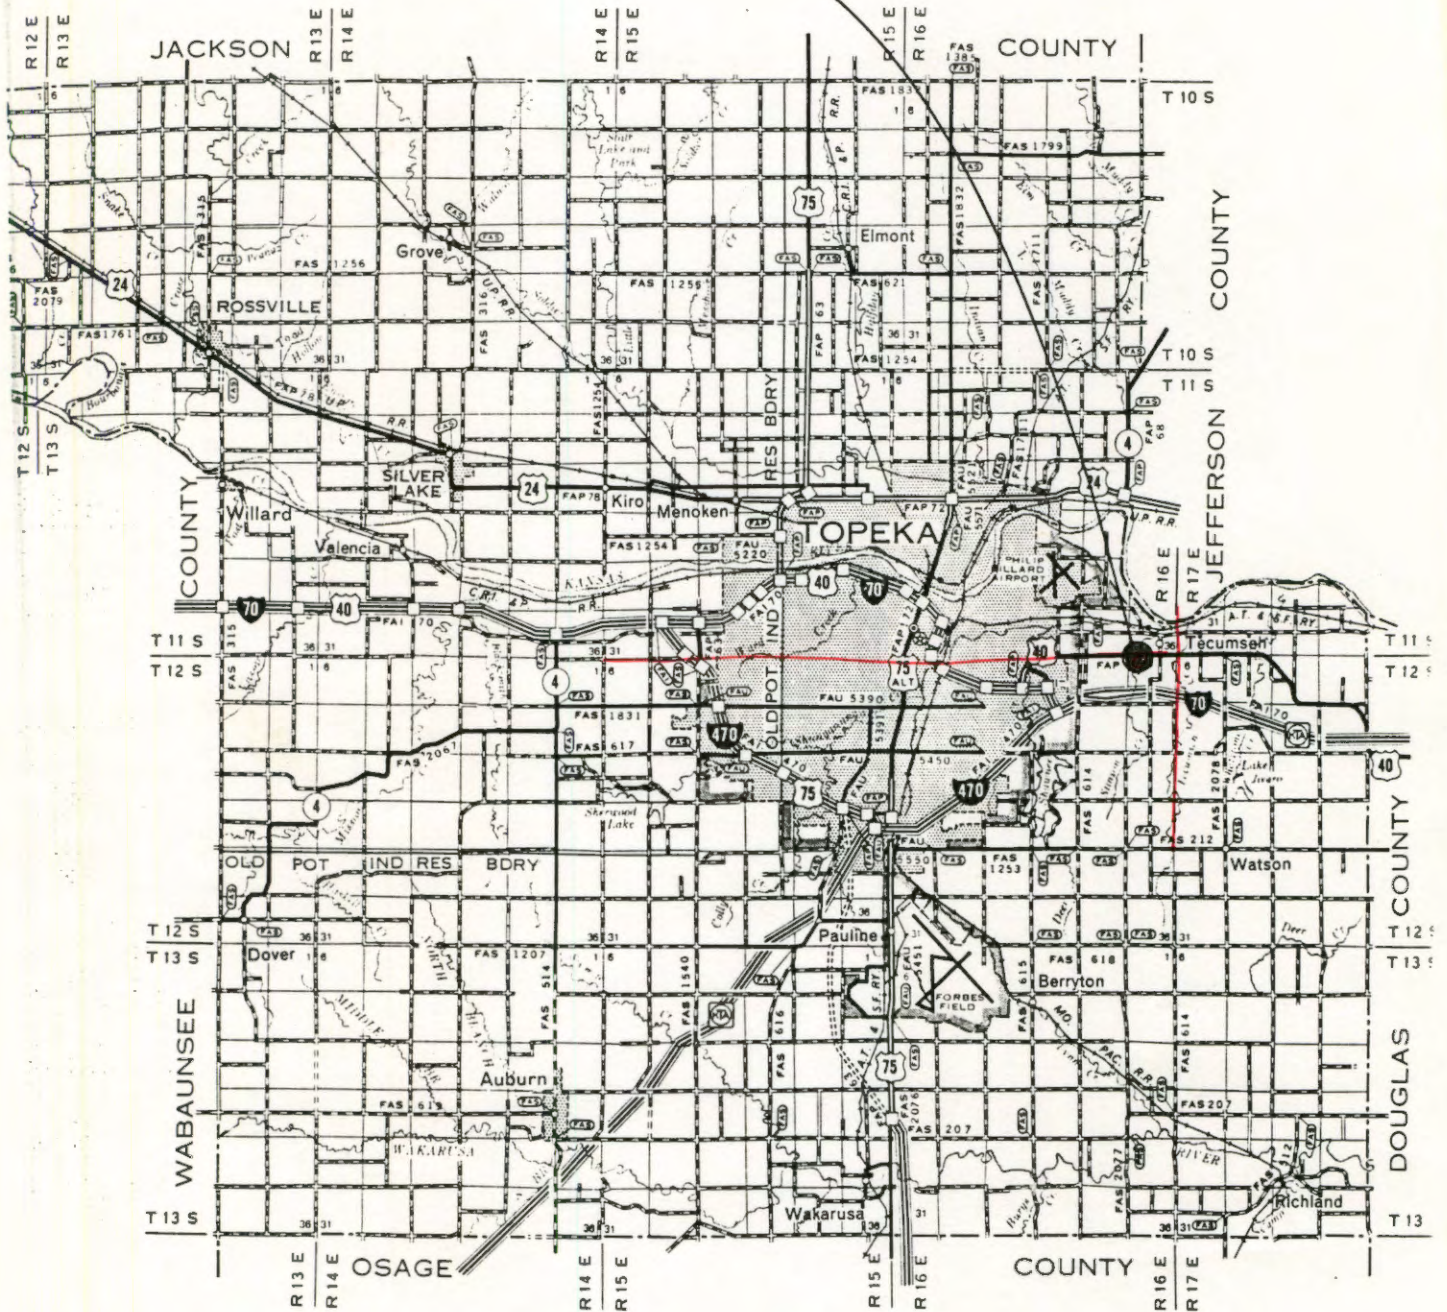

NW-NW-1-125-16E
 0-43
 Shawnee
 Tecumseh shale


LEGEND

BRIDGE AND ROADWAY FEATURES

AD-PAVED ROAD	=====
UNPAVED ROAD	-----
NE ROAD-OR DRAINED	-----
NE ROAD-DRAINED	-----
NE ROAD WITH INFRA	-----
AD-LOW TYPE	-----
W	-----
FULL CONTROL OF INTERCHANGE	-----

ROAD SYSTEM DESIGNATION

FEDERAL-AID INTERSTATE HIGHWAY SYSTEM	-----
FEDERAL-AID PRIMARY HIGHWAY SYSTEM	-----
FEDERAL-AID SECONDARY HIGHWAY SYSTEM	-----
INTERSTATE NUMBERED HIGHWAY	-----
U S NUMBERED HIGHWAY	-----
STATE HIGHWAY SYSTEM OR STATE NUMBERED HIGHWAY	-----
END OF DESIGNATED SYSTEM OR MARKED ROUTE	-----

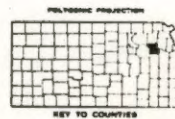

FA SYSTEMS REVISED TO MAY 1, 1978

GENERAL HIGHWAY MAP
 SHAWNEE COUNTY
 KANSAS

PREPARED BY THE
 KANSAS DEPARTMENT OF TRANSPORTATION
 PLANNING AND DEVELOPMENT DEPARTMENT
 IN COOPERATION WITH THE
 U. S. DEPARTMENT OF TRANSPORTATION
 FEDERAL HIGHWAY ADMINISTRATION

